AAP

IREDELL COUNTY HEALTH DEPARTMENT

Statesville Office (704) 878-5305 Mooresville Office (704) 660-3625 PERMIT # 211610

IMPROVEMENT PERMIT / AUTHORIZATION TO CONSTRUCT / OPERATION PERMIT / EXISTING SYSTEM

PIN # 4724-16-8432

APPLICANT: ROBERT GLEAVES APPLICANT ADDRESS: 2500 DELLWOOD DR. MONROE

SITE ADDRESS: 709 WELLWOOD DR. STATESVILLE PHONE: 704-807-3680 ALT. PHONE: N/A


SITE DIRECTIONS: WESTMINESTER TO CRESTRIDGE, TR WESTMORE, TR WELLWOOD, ON R

SUBDIVISION: WESTOVER SECTION: N/A LOT # 101 LOT AREA: 0.39 acres DESIGN FLOW: 360 L.T.A.R.: .3

Septic Tank	EXISTING	(gal)	STB		Date		☐ New System	☒ Repair	☐ Expansion	System Type: I II (III) IV V VI	☒ Residence	No. Bedrooms	3	Water Supply
Pump Tank		(gal)	PT		Date		System Description:				☐ Business	No. Persons		☐ Private
Pump Make		Model			Serial #		Repair System Description:	PANEL ROCK			☐ Other	No. Employees		☒ Public
# Nitrification Fields	1	# Lines	6@34'		Linear Ft:	204'	Maintenance Agreement Required:	☐ YES	☒ NO		☒ Slab	☐ Crawl Space		☐ Community
Trench Width	24"	Max. Trench Bottom Depth	33"		Gravel Depth	—		☒ GRAVITY	☐ PRESSURE		☒ Basement w/plumbing		☐ Basement w/o plumbing	

Comments / Conditions: REMOVE DECK & CHECK STRUCTURAL INTEGRITY OF TANK. REPLACE TANK IF NEEDED. REPLACE EXISTING D-BOX IF NEEDED. SET BULL RUN VALVE AS SHOWN. KEEP 6' BETWEEN OLD & NEW SYSTEMS

INITIAL SITE SKETCH

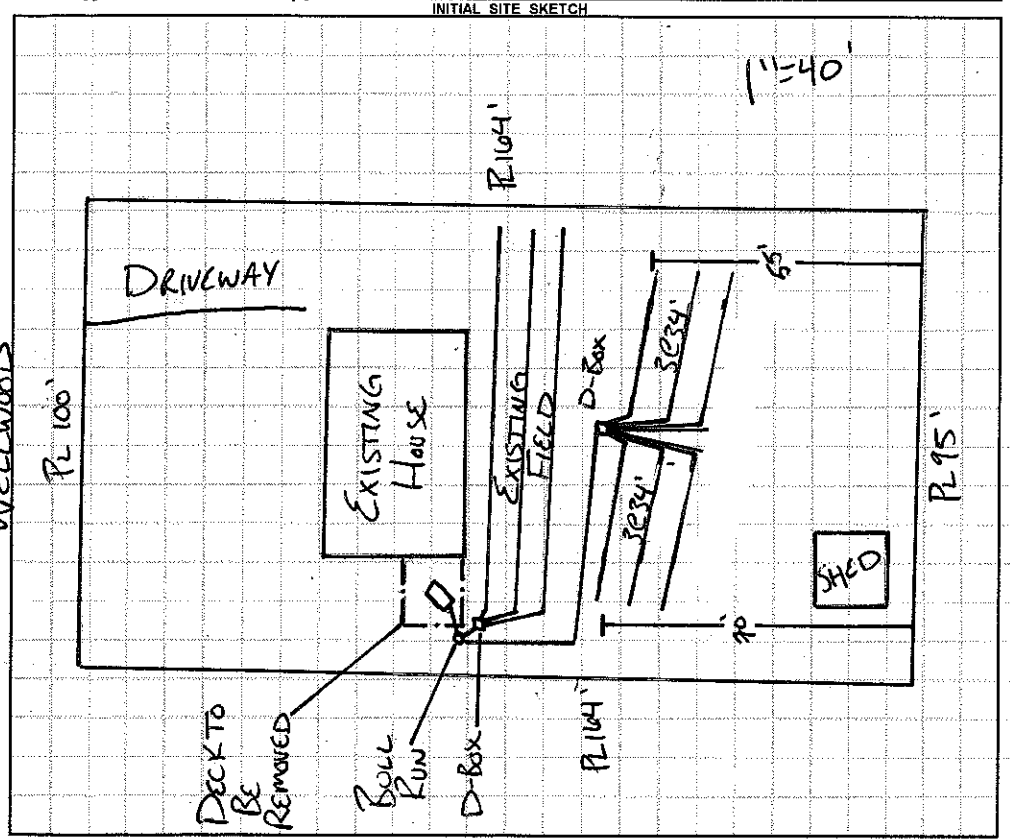

AS BUILT SKETCH

Installed as Drawn

Permit can be suspended or revoked if any false information is supplied toward securing the permit / any unauthorized changes are made to the site / any unauthorized changes are made in the installation of the system. **CONTACT A LOCATOR SERVICE PRIOR TO ANY EXCAVATION**

☐ **IMPROVEMENT PERMIT** *with plat valid without expiration.* ☐ **IMPROVEMENT PERMIT** *with site plan valid for 60 mos.* ☒ **AUTHORIZATION TO CONSTRUCT** *valid for period equal to IMPROVEMENT PERMIT--not to exceed 60 mo.*

Owner / Applicant Signature: Date:

Installed by: K+M Grading

IMPROVEMENT PERMIT by: APPROVED Date: JUL 13 2015

OPERATION PERMIT by: Justin Henderson Date: 7-30-15

AUTHORIZATION TO CONSTRUCT by: APPROVED Date: JUL 13 2015

Existing System Inspected by: Date:

Health Dept. Copy - WHITE Applicant (Final Approval) - YELLOW Applicant (Conditional Approval) - PINK