IREDELL COUNTY HEALTH DEPARTMENT - *ENVIRONMENTAL HEALTH* ☒ STATESVILLE OFFICE 704-878-5305 ☐ MOORESVILLE OFFICE 704-664-5281

IMPROVEMENT PERMIT / AUTHORIZATION TO CONSTRUCT / OPERATION PERMIT / EXISTING SYSTEM INSPECTION

PERMIT # 10542 PIN # 4724-18-1490 DATE 3-9-12

OWNER Heather + Shannon Williamson APPLICANT: PHONE: Home/Cell # 704-878-6474 Business # 704-682-0585

SITE ADDRESS 452 Island Ford Rd. OWNER / APPLICANT ADDRESS

SITE DIRECTIONS I-40W; x 148 (R); (L) at 1st light; 1mi site on (R)

SUBDIVISION n/a BLOCK / SECTION n/a LOT # LOT AREA 6.999 DESIGN FLOW 480 L.T.A.R. .3

Septic Tank 1000 Gallons: STB 760 Date 5-25

Pump Tank Gallons: P T Date

Pump Make Model Serial #

No. Nitrification Fields: 1 No. Lines Linear Feet 400

Trench Width 36" Max. Trench Bottom Depth 36" Gravel Depth n/a

☒ New System ☐ Repair ☐ Expansion System Type I II (III) IV V VI

System Description: 25% Reduction Gravity

Repair System Description: 25% Reduction Gravity

Maintenance Agreement Required ☐ YES ☒ NO

☒ GRAVITY ☐ PRESSURE

☒ Residence No. Bedrooms 4

☐ Business No. Persons

☐ Other No. Employees


☐ Slab ☐ Crawl Space

☒ Basement w/plumbing ☐ Basement w/o plumbing


Water Supply: ☒ Private ☐ Public ☐ Community

Comments / Conditions

INITIAL SITE SKETCH

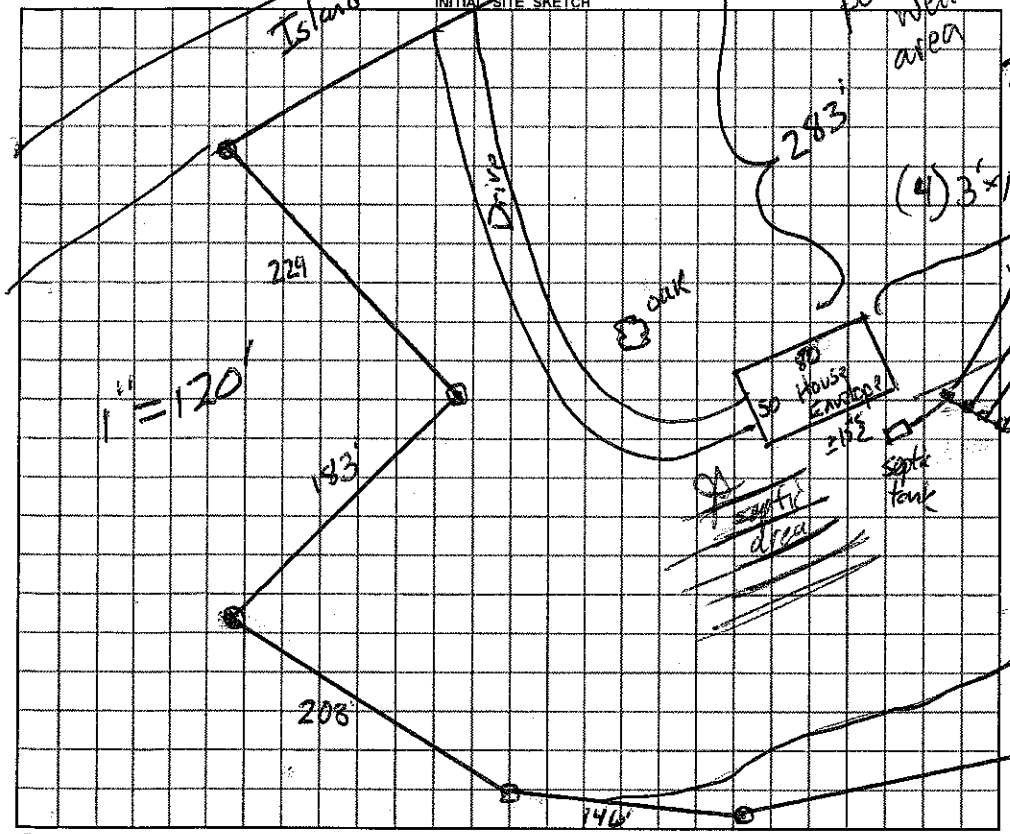

AS BUILT SKETCH

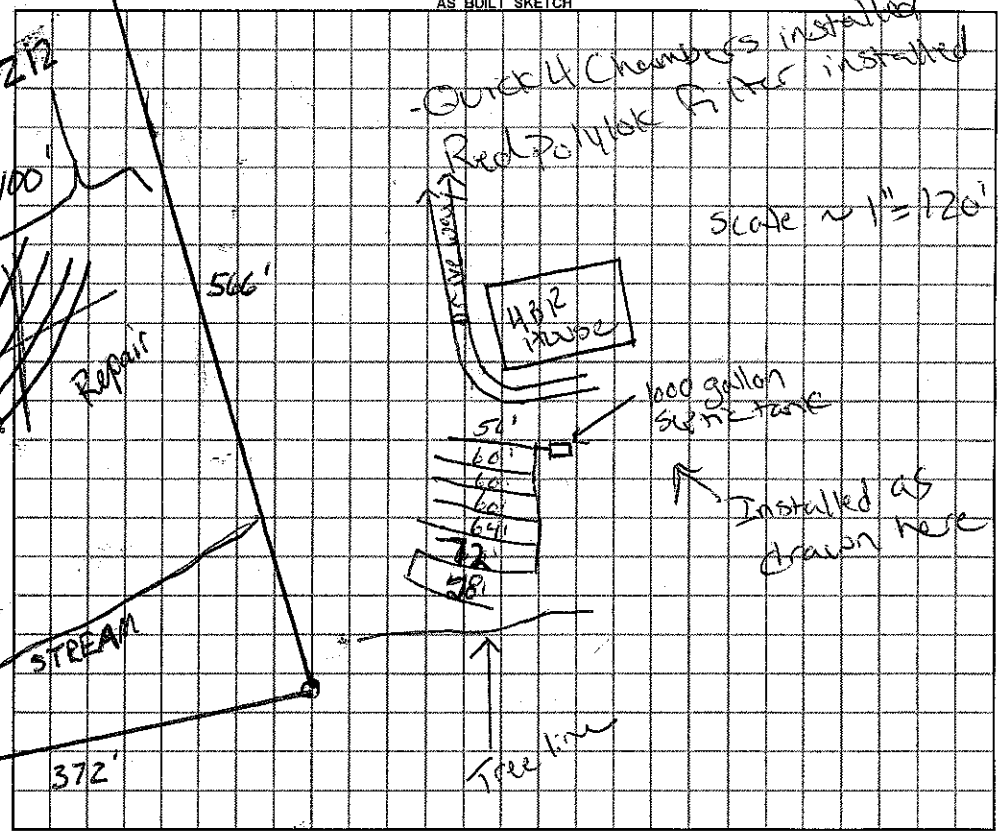

Permit can be suspended or revoked if any false information is supplied toward securing the permit / any unauthorized changes are made to the site / any unauthorized changes are made in the installation of the system.

☐ ***IMPROVEMENT PERMIT*** with plat valid without expiration. ☒ ***IMPROVEMENT PERMIT*** with plat valid ~~without expiration~~ site plat valid 60 mo. ☒ ***AUTHORIZATION TO CONSTRUCT*** valid for period equal to IMPROVEMENT PERMIT--not to exceed 60 mo.

Owner / Applicant Signature: Heather Williamson Date 3/14/12 Installed by: A1 Backhoe

IMPROVEMENT PERMIT by: REHS Date 3-9-12 OPERATION PERMIT by: REHS Date 10-30-12

AUTHORIZATION TO CONSTRUCT by: REHS Date 3-9-12 Existing System Inspected by: REHS Date

YOU SHOULD CONTACT A LOCATOR SERVICE PRIOR TO ANY EXCAVATION

White Copy – Environmental Health YELLOW COPY (Final) Owner / Applicant PINK COPY (Initial) Owner / Applicant