IREDELL COUNTY HEALTH DEPARTMENT

STATESVILLE 704-878-5305 MOORESVILLE 704-664-5281

IMPROVEMENT PERMIT / CERTIFICATE OF COMPLETION / OPERATION PERMIT / EXISTING SYSTEM INSPECTION

PROPERTY DESCRIPTION NO. _____ DATE 2-25-97 TAX MAP NO. _____

OWNER OR CONTRACTOR Jack Tucker PHONE: Business _____ Home 872 4923 Watersned: ☐ Yes ☐ No

ADDRESS 150 Airport Rd

LOCATION 70 W TL Airport Rd 8th Hse Lft.

SUBDIVISION _____ BLOCK / SECTION _____ LOT _____ LOT AREA 1 acre± SITE CLASS. PS DESIGN FLOW _____ L.T.A.R. _____

Septic Tank: Ex. Gallons; STB _____ Date _____

Pump Tank: _____ Gallons; PT _____ Date _____

Pump Make: _____ Model _____ Serial No. _____

Nitrification Field: No Fields 1 Square Feet 210 Linear Feet 170

No Lines 1 Trench Width 36" Max Trench Bottom Depth 72" Gravel Depth 18"

☐ New System ☑ Repair System Type: I, II, III, IV, V, VI

System Description: _____

Repair System Description: Sanit Lined Trench

Maintenance Agreement Required: ☐ Yes ☐ No

☑ House/Mod. Home No. Bedrooms ____

☐ Mobile Home No. Bathrooms ____

☐ Business No. Employees ____

☐ Other _____


☐ Slab ☐ Crawl Space ☐ Basement w/plumbing ☐ Basement wo/plumbing

Water Supply: ☐ Individual ☐ Community ☑ Public


Comments:

Comments: + 36" Sand

INITIAL SITE SKETCH

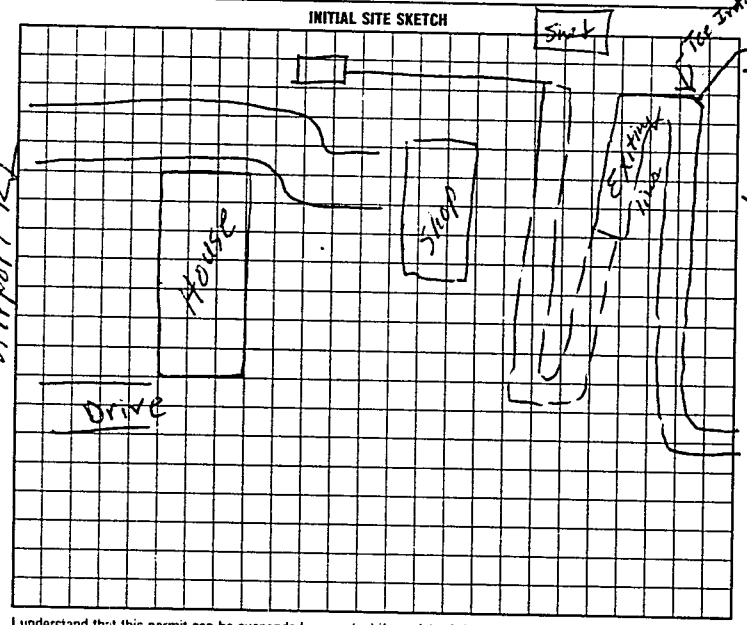

AS BUILT SKETCH

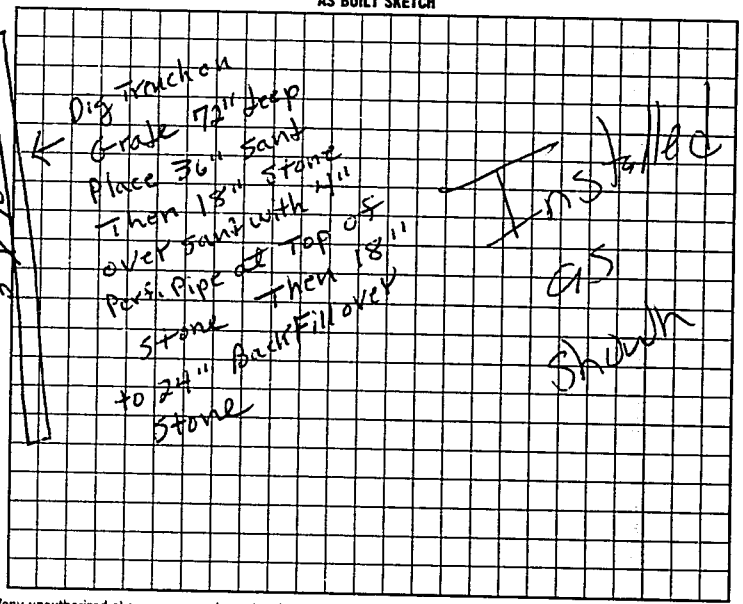

I understand that this permit can be suspended or revoked if any false information is supplied toward securing the permit/any unauthorized changes are made to the site/any unauthorized changes are made in the installation of the system. Improvement Permit is valid for 60 months from date of issuance.

Signed: Jack Tucker

Improvement Permit by: R.C. Moore date 2-25-97

Authorization to cover Existing System Inspection by: R.C. Moore date 2-25-97

Installed by: James Huddler

Certificate of Completion by: _____ date _____

Operation Permit by: Mark C Oates date 4-1-97

HEALTH DEPT COPY: WHITE INSPECTION COPY (FINAL) GREEN OWNER COPY (FINAL) YELLOW INSPECTION COPY (INITIAL) PINK OWNER COPY (INITIAL) BLUE

Authorization to cover

Expires 60 mos from issue

2 2 0 2 0 0