IREDELL COUNTY HEALTH DEPARTMENT - *ENVIRONMENTAL HEALTH* ☐ STATESVILLE OFFICE 704-878-5305 ☐ MOORESVILLE OFFICE 704-664-5281

IMPROVEMENT PERMIT / AUTHORIZATION TO CONSTRUCT / OPERATION PERMIT / EXISTING SYSTEM INSPECTION

PERMIT # 171625 PIN # 4724-22-4619 DATE AUGUST 31, 2012

OWNER STEVEN E. EAGLE APPLICANT: SAME PHONE: Home/Cell # 704-902-6787 Business # 704-902-3756

SITE ADDRESS 2498 HICKORY HIGHWAY OWNER / APPLICANT ADDRESS

SITE DIRECTIONS US 70 WEST ~1 ON RIGHT ~~AT~~ AIRPORT ROAD AT BOX #2498

SUBDIVISION EARL EDISON BLOCK / SECTION LOT # 13 & 14 LOT AREA 0.62 ACRE DESIGN FLOW 100 GPD L.T.A.R. EXIST.

Septic Tank 900 Gallons: STB Date

Pump Tank Gallons: P T Date

Pump Make Model Serial #

No. Nitrification Fields: 1 No. Lines 1 Linear Feet ~150

Trench Width BED Max. Trench Bottom Depth EX Gravel Depth EX

☐ New System ☐ Repair ☐ Expansion System Type I II III IV V VI

System Description: CONVENTIONAL GRAVITY

Repair System Description:

Maintenance Agreement Required ☐ YES ☑ NO

☑ GRAVITY ☐ PRESSURE

☐ Residence ☑ Business ☐ Other ☐ Slab ☐ Crawl Space ☑ Basement w/plumbing ☐ Basement w/o plumbing


No. Bedrooms No. Persons No. Employees 2

Water Supply: ☐ Private ☑ Public ☐ Community


Comments / Conditions

CHANGE OF USE PERMIT FOR AUTOMOBILE DEALERSHIP

INITIAL SITE SKETCH

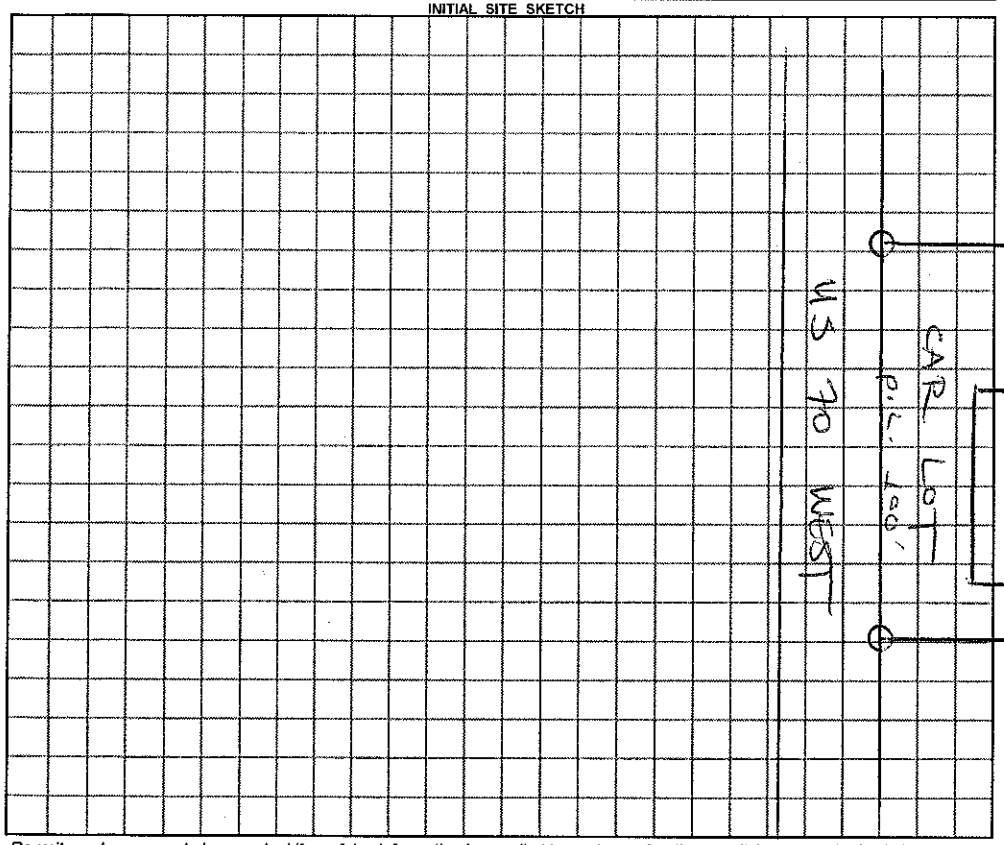

AS BUILT SKETCH

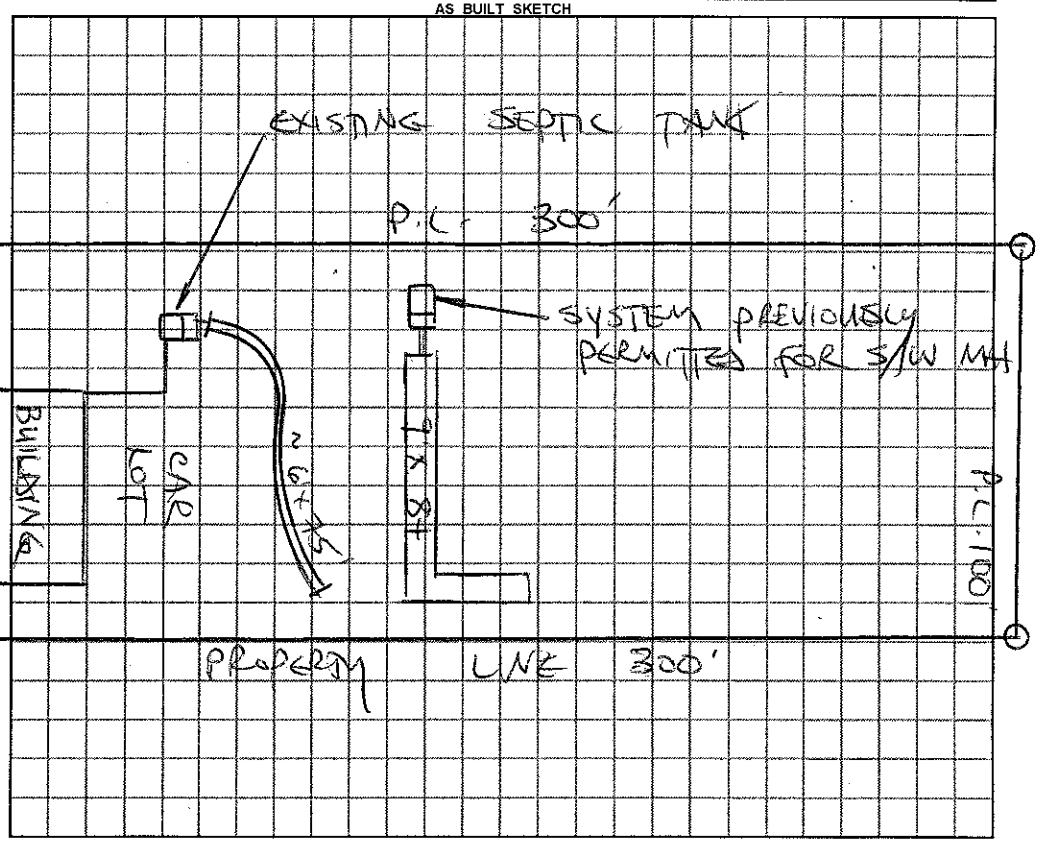

Permit can be suspended or revoked if any false information is supplied toward securing the permit / any unauthorized changes are made to the site / any unauthorized changes are made in the installation of the system.

☐ ***IMPROVEMENT PERMIT*** *with plat valid without expiration.* ☐ ***IMPROVEMENT PERMIT*** *with ~~plat valid without expiration.~~ site plan valid 60 mo.* ☐ ***AUTHORIZATION TO CONSTRUCT*** valid for period equal to IMPROVEMENT PERMIT--not to exceed 60 mo.

Owner / Applicant Signature: Date Installed by:

IMPROVEMENT PERMIT by: ***REHS*** Date OPERATION PERMIT by: ***REHS*** Date

AUTHORIZATION TO CONSTRUCT by: ***REHS*** Date Existing System Inspected by: STEVE HENDRICK ***REHS*** Date 8/31/2012

YOU SHOULD CONTACT A LOCATOR SERVICE PRIOR TO ANY EXCAVATION

White Copy – Environmental Health YELLOW COPY (Final) Owner / Applicant PINK COPY (Initial) Owner / Applicant