IREDELL COUNTY HEALTH DEPARTMENT

Statesville Office (704) 878-5305 Mooresville Office (704) 660-3625 PERMIT # 212867

IMPROVEMENT PERMIT / AUTHORIZATION TO CONSTRUCT / OPERATION PERMIT / EXISTING SYSTEM

PIN # 4724 237686

APPLICANT: Dennis Watkins APPLICANT ADDRESS: 161 Brandy Ln Statesville NC

SITE ADDRESS: 161 Brandy Ln Statesville NC PHONE: 704-902-5360 ALT. PHONE: N/A

SITE DIRECTIONS: 70 to Bristol T/R Westminster T/R on Brandy Lot on left

SUBDIVISION: N/A SECTION: N/A LOT # N/A LOT AREA: 2.115 ac DESIGN FLOW: Ex L.T.A.R.: Ex

Septic Tank 1000 (gal) STB 760-1000 Date 7-12
Pump Tank (gal) PT Date
Pump Make Model Serial #
Nitrification Fields Ex # Lines Ex Linear Ft: Ex
Trench Width Ex Max. Trench Bottom Depth Ex Gravel Depth Ex


☐ New System ☒ Repair ☐ Expansion System Type: I ☒ II ☐ III ☐ IV ☐ V ☐ VI
System Description: Tank
Repair System Description:
Maintenance Agreement Required: ☐ YES ☒ NO
☒ GRAVITY ☐ PRESSURE

☒ Residence No. Bedrooms Ex
☐ Business No. Persons Ex
☐ Other No. Employees
☐ Slab ☐ Crawl Space
☒ Basement w/plumbing ☐ Basement w/o plumbing

Water Supply: ☒ Private ☐ Public ☐ Community

Comments / Conditions: Pump, crush & fill existing tank. Maintain 5' off any building foundation and 50' off any well. Use risers if needed.

INITIAL SITE SKETCH

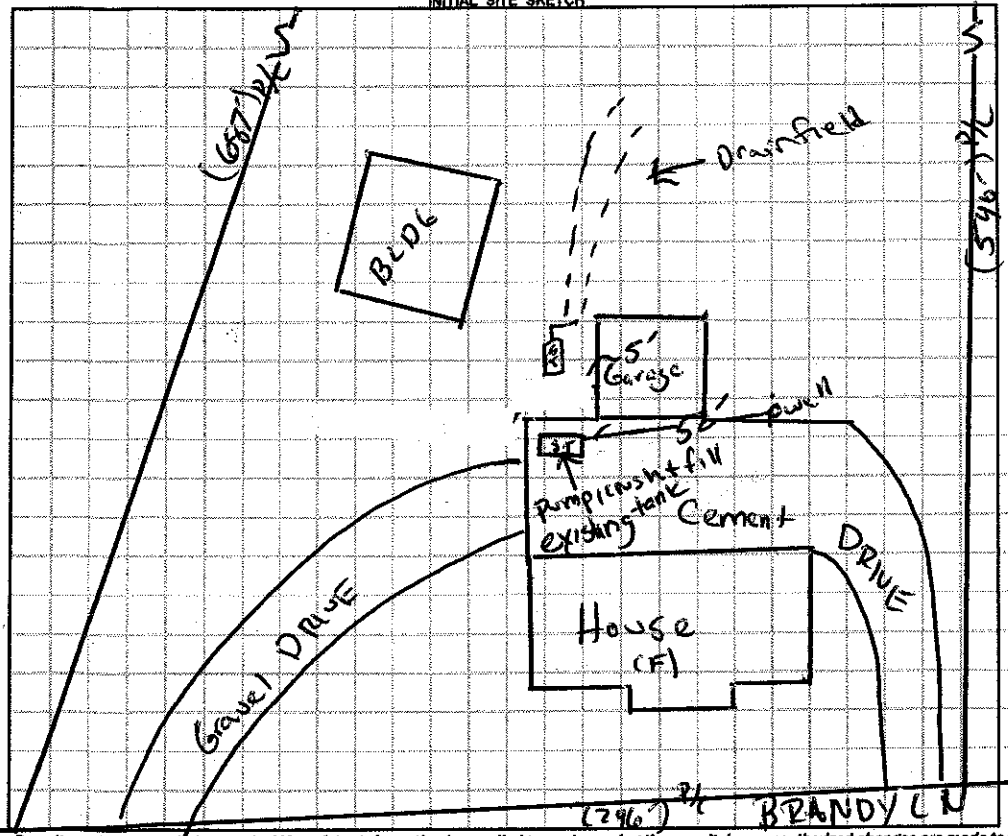

AS BUILT SKETCH

1" = 50

- Risers installed on S.T.
- Red Poly/ex fitt installed

Permit can be suspended or revoked if any false information is supplied toward securing the permit / any unauthorized changes are made to the site / any unauthorized changes are made in the installation of the system. **CONTACT A LOCATOR SERVICE PRIOR TO ANY EXCAVATION**

☐ **IMPROVEMENT PERMIT** *with plat valid without expiration.* ☒ **IMPROVEMENT PERMIT** *with site plan valid for 60 mos.* ☒ **AUTHORIZATION TO CONSTRUCT** *valid for period equal to IMPROVEMENT PERMIT--not to exceed 60 mo.*

Owner / Applicant Signature: Pat Watkins Date:

IMPROVEMENT PERMIT by: Date: 08/24/15

AUTHORIZATION TO CONSTRUCT by: Date: 08/24/15

Installed by: Lentz

OPERATION PERMIT by: Justin Henderson Date: 8-31-15

Existing System Inspected by: Date:

Health Dept. Copy - WHITE Applicant (Final Approval) - YELLOW Applicant (Conditional Approval) - PINK