IREDELL COUNTY HEALTH DEPARTMENT

(SEPTIC TANK) IMPROVEMENTS PERMIT AND CERTIFICATE OF COMPLETION
(Ground Absorption Sewage Disposal System — G. S. Chapter 130-Article 13C)

OWNER OR CONTRACTOR Hope Bro DATE 4/18/77 PERMIT NO. _____

PHONE: Business _____ Home _____

LOCATION Crestridge Drive S. R. No. _____

SUBDIVISION NAME Westover Addition LOT NO. 9 SECTION OR BLOCK NO. _____


House (✓) Mobile Home ( ) Business ( ) Other _____

No. Bedrooms 3 No. Bathrooms 2

Garbage Disposal Unit	Yes ( )	No (✓)
Auto. Dishwasher	Yes (✓)	No ( )
Auto. Wash. Machine	Yes (✓)	No ( )
Site Suitable	Yes (✓)	No ( )

Lot Area 15000 Sq ft

Character & Porosity of Soil Red Clay
Percolation Rate _____
Topography Slope to road
Depth to Water Table Low
Rock or other impervious formations None

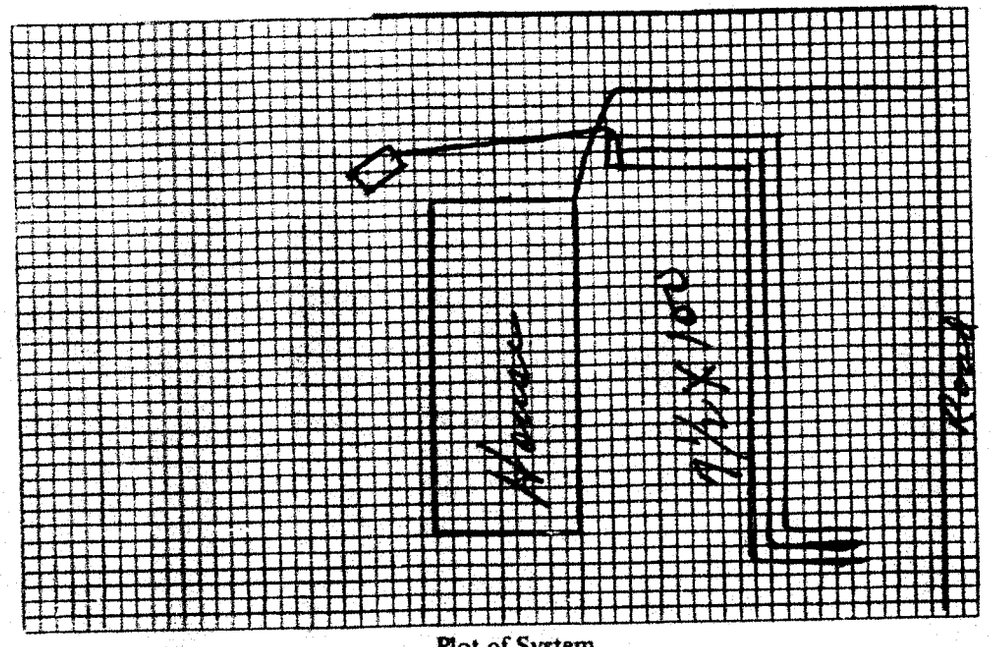

Plot of System

Size of Tank 1000 Gals.
Nitrification Field:
No. of Lines 3
Sq. Ft. 750 Linear Ft. 300
Depth of Stone in Lines 10"
Water Supply: Individual ( )
Public (✓)

Installed by Hope Bro

IMPROVEMENTS PERMIT BY _____

COMMENTS: Water from downspouts to be diverted away from Septic Tank & lines. Not installed as laid out.

CERTIFICATE OF COMPLETION BY E. A. Stevenson DATE 4/18/77

CONSTRUCTION MUST COMPLY WITH ALL OTHER APPLICABLE STATE AND LOCAL REGULATIONS.

Health Dept. Copy: White Inspection Dept. Copy: Yellow Sanitarian's Copy: Pink Owner's Copy: Gold