IREDELL COUNTY HEALTH DEPARTMENT

STATESVILLE 704-878-5305 MOORESVILLE 704-664-5281

IMPROVEMENT PERMIT / AUTHORIZATION TO CONSTRUCT / OPERATION PERMIT / EXISTING SYSTEM INSPECTION

PERMIT# Repair PIN# DATE 5-1-01

OWNER OR CONTRACTOR Norma Ramsey PHONE Business — Home (704) 878-6930

ADDRESS 810 Chal Drive Statesville NC, 28677

LOCATION

SUBDIVISION Westover BLOCK / SECTION LOT 17 LOT AREA about .38 Acre SITE CLASS 05 DESIGN FLOW 360 L.T.A.R. .25

Septic Tank: Gallons: STB Date

Pump Tank: Gallons: PT Date

Pump Make: Model Serial No.

Nitrification Field: No Fields 1 Square Feet 630' Linear Feet ~210'

No Lines 2 Trench Width 36" Max Trench Bottom Depth 36"

☐ New System ☒ Repair System Type: I (II) III. IV. V. VI

System Description:

Repair System Description: Gravity Conventional

Maintenance Agreement Required: ☐ Yes ☒ No

Gravel Depth 18" ☐ Slab ☒ Crawl Space ☐ Basement w/plumbing ☐ Basement wo/plumbing

☒ House/Mod. Home No. Bedrooms 3

☐ Mobile Home No. Bathrooms 3

☐ Business Also No. Employees


☒ Other Home Day Care 5 Kids

Water Supply: ☒ Individual ☒ Public ☐ Community


Comments/Conditions: ① Add Two (2) Lines with min 3'0" feet length total. ② Connect new lines into existing distr. box ③ Replace Sanitary Tee if necessary

Comments/Conditions: w/drop box * Keep Surface water off System install gutters on house. Aerate backyard this Fall, 2001. Noticed 8 kids on 7/24/01

INITIAL SITE SKETCH Not to scale

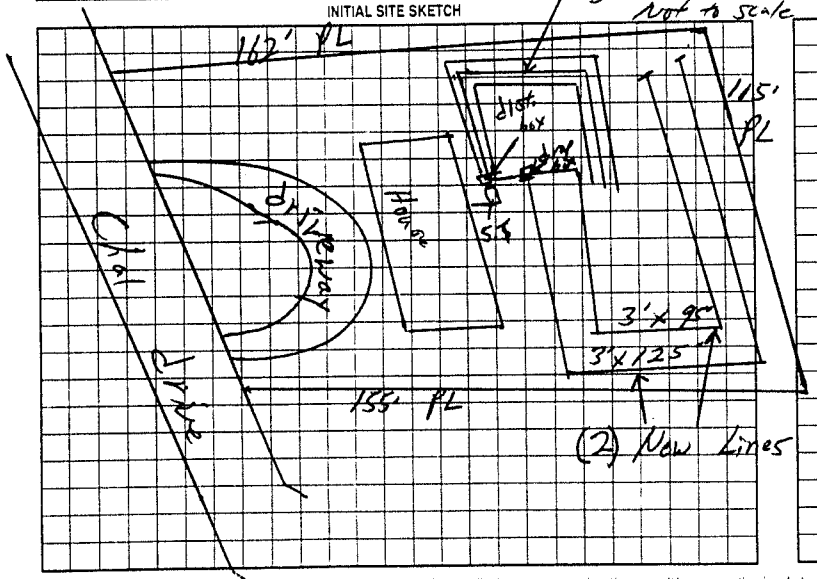

AS BUILT SKETCH

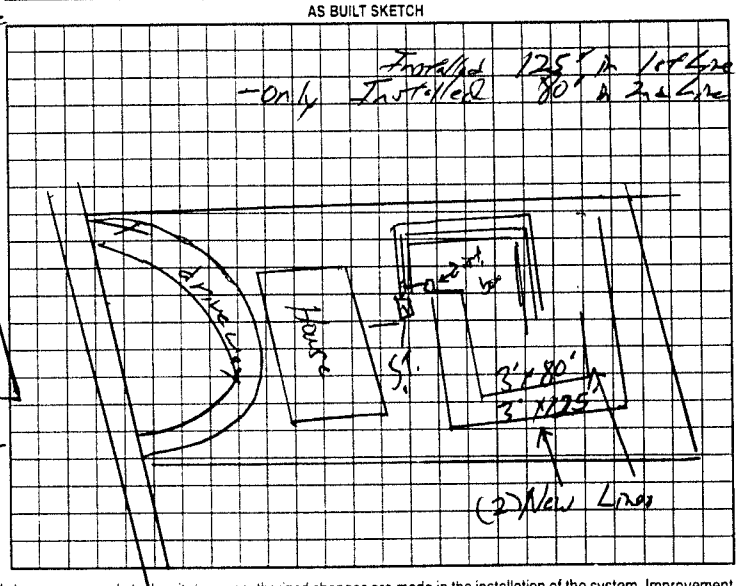

Permit can be suspended or revoked if any false information is supplied toward securing the permit/any unauthorized changes are made to the site/any unauthorized changes are made in the installation of the system. Improvement Permit with plat valid without expiration. Improvement Permit with site plan valid for sixty months. Authorization to Construct is valid for a period equal to that of Improvement Permit – not to exceed sixty months.

Signed: Norma Ramsey date

Improvement Permit by: William O. Johnson RSI date 5-1-01

Authorization to Construct by: William O. Johnson RSI date 5-1-01

Installed by: Barry Eggmon

Operation Permit by: William O. Johnson date 7/24/01

Existing System Inspection by: date

HEALTH DEPT COPY WHITE OWNER COPY (FINAL) YELLOW OWNER COPY (INITIAL) PINK