IREDELL COUNTY HEALTH DEPARTMENT - *ENVIRONMENTAL HEALTH* ☑ STATESVILLE OFFICE 704-878-5305 ☐ MOORESVILLE OFFICE 704-664-5281

IMPROVEMENT PERMIT / AUTHORIZATION TO CONSTRUCT / OPERATION PERMIT / EXISTING SYSTEM INSPECTION

PERMIT # Repair PIN # 4724267083 DATE 7-13-12

OWNER Annie Davidson APPLICANT: Same PHONE: Home/Cell # 704-872-3047 Business # N/A

SITE ADDRESS 703 Crestridge Rd. Statesville OWNER / APPLICANT ADDRESS 776 Idaho Rd. Statesville

SITE DIRECTIONS 64 to Westminster TL on Westover, Straight onto Crestridge

SUBDIVISION Westover BLOCK / SECTION N/A LOT # 1 LOT AREA 0.55 acres DESIGN FLOW 360 gpd. L.T.A.R. Existing

Septic Tank 1000 Gallons: STB 1000 Date 6-4-12

Pump Tank ____ Gallons: P T ____ Date ____

Pump Make ____ Model ____ Serial # ____

No. Nitrification Fields: 1 No. Lines 2 Linear Feet 300

Trench Width Existing Max. Trench Bottom Depth Existing Gravel Depth Existing

☐ New System ☑ Repair ☐ Expansion System Type I (II) III IV V VI

System Description: Replace Tank

Repair System Description: ____

Maintenance Agreement Required ☐ YES ☑ NO

☑ GRAVITY ☐ PRESSURE

☑ Residence No. Bedrooms 3

☐ Business No. Persons ____

☐ Other No. Employees ____

☐ Slab ☑ Crawl Space

☐ Basement w/plumbing ☐ Basement w/o plumbing

Water Supply


☐ Private

☐ Public

☑ Community

Comments / Conditions - Pump & Crush old Septic tank. Install new septic tank 19' from house & connect to existing drainfield.

INITIAL SITE SKETCH

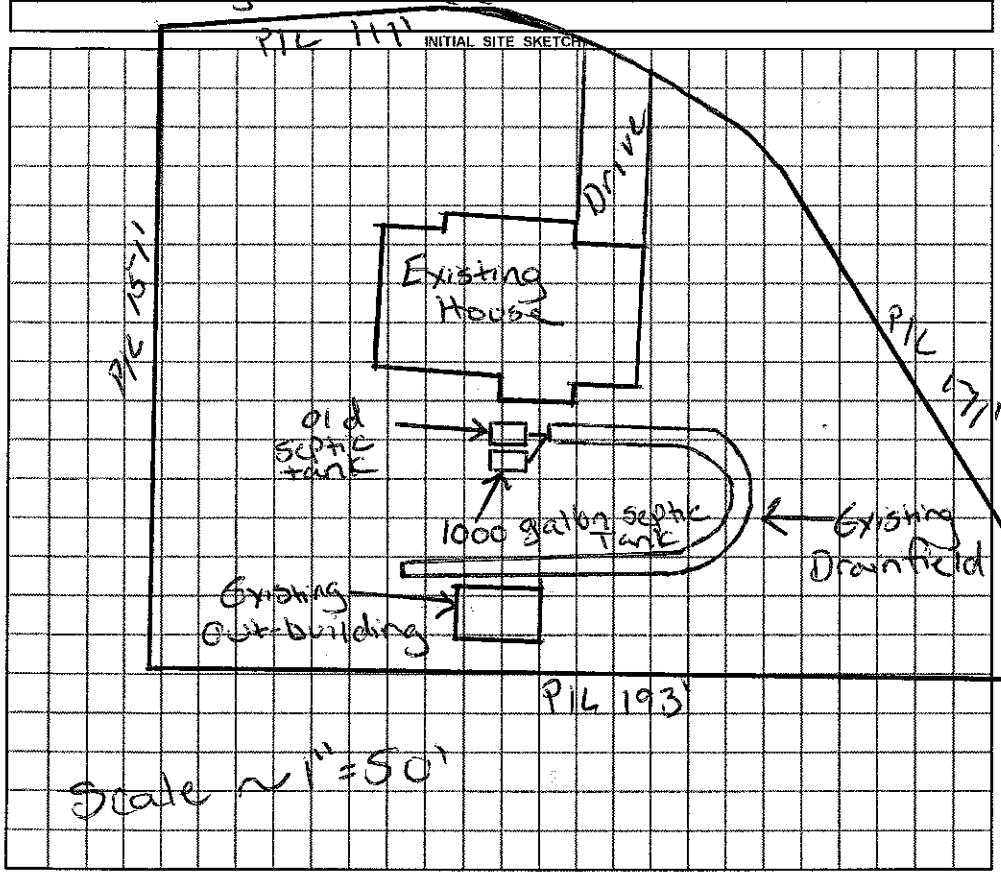

AS BUILT SKETCH

Installed as drawn
Red Polylock Filter
2" PVC tank markers

Permit can be suspended or revoked if any false information is supplied toward securing the permit / any unauthorized changes are made to the site / any unauthorized changes are made in the installation of the system.

☐ ***IMPROVEMENT PERMIT*** with plat valid without expiration. ☑ ***IMPROVEMENT PERMIT*** with ~~plat valid without expiration~~ site plan valid 60 mo. ☑ ***AUTHORIZATION TO CONSTRUCT*** valid for period equal to IMPROVEMENT PERMIT--not to exceed 60 mo.

Owner / Applicant Signature: Annie R Davidson Date 7/16/12

IMPROVEMENT PERMIT by: Justin Henderson REHS Date 7-13-12

AUTHORIZATION TO CONSTRUCT by: Justin Henderson REHS Date 7-13-12

Installed by: K+M Grading

OPERATION PERMIT by: Justin Henderson REHS Date 7-24-12

Existing System Inspected by: ____ REHS Date ____

YOU SHOULD CONTACT A LOCATOR SERVICE PRIOR TO ANY EXCAVATION

White Copy – Environmental Health YELLOW COPY (Final) Owner / Applicant PINK COPY (Initial) Owner / Applicant