IREDELL COUNTY HEALTH DEPARTMENT

Statesville Phone TR 3-7271 Mocresville Phone No. 664-5281

PERMIT TO INSTALL SEPTIC TANK

Permit No. 1 Permit Date 8-9 1973

Owner Jeff Harne Bldr. Address Statesville NC

Installed By York Rufty Address Stony Point NC


Location of Property Westminister Drive to Jurney Ave. Turn on Jurney. Tk. 2nd Street House on R. Weston Ext. Lot # 33

Tank		Capacity		Length of Lines		Fixtures	
Block	( )	1000	(✓)	225'	( )	No. of Baths	1½
Precast	(✓)	1250	( )	250'	( )	Dishwasher	(—)
		1500	( )	Other 300		Garbage Grdr.	(—)
		Other		900 sq ft		Other	

NOTIFY HEALTH DEPARTMENT AT LEAST EIGHT HOURS BEFORE TANK IS TO BE INSPECTED.

Final Inspection 8-9 1973 Approved (✓) Disapproved ( )

Remarks Community Water

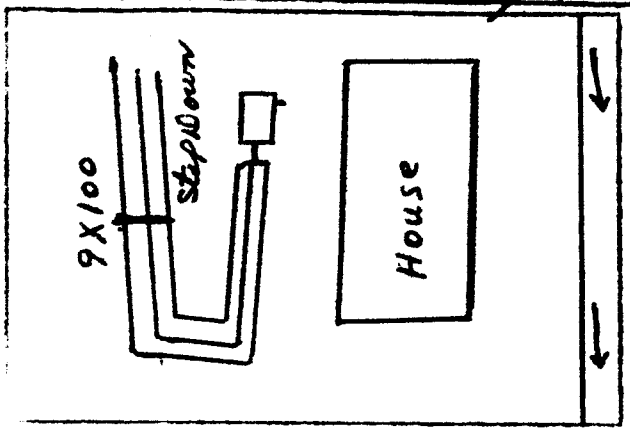

Sketch of Installation

E. G. Stevenson
Sanitarian