IREDELL COUNTY HEALTH DEPARTMENT

Statesville Phone TR 3-7271 Mooresville Phone No. 664-5281

PERMIT TO INSTALL SEPTIC TANK

Permit No. 159 Permit Date 1-26 1973

Owner Jeffrey Horne Bldr Address Statesville NC

Installed By Jack Rufty Address Stony Point NC


Location of Property Out Westmineter Dr to Jurney ave #1408 T.R. Last house on L. at End of Street.

Tank		Capacity		Length of Lines		Fixtures	
Block	( )	1000	(✓)	225'	(✓)	No. of Baths	(1½)
Precast	(✓)	1250	( )	250'	( )	Dishwasher	(—)
		1500	( )	Other		Garbage Grdr.	(—)
		Other				Other	

NOTIFY HEALTH DEPARTMENT AT LEAST EIGHT HOURS BEFORE TANK IS TO BE INSPECTED.

Final Inspection 1-31 1973 Approved (✓) Disapprcved ( )

Remarks Community Water

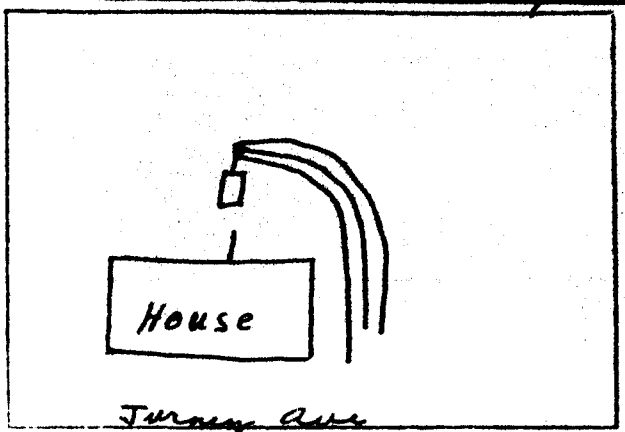

Sketch of Installation

E. A. Stevenson
Sanitarian