IREDELL COUNTY HEALTH DEPARTMENT

Statesville Phone TR 3-7271 Mooresville Phone No. 664-5281

PERMIT TO INSTALL SEPTIC TANK

Permit No. 226 Permit Date 3-16 19 73

Owner Hope Bro Address Statesville NC

Installed By Hope Bro Address Statesville NC


Location of Property Out Westminster Dr.
Turn on Cliffwood Drive House at end of Road

Tank		Capacity		Length of Lines		Fixtures	
Block	( )	1000	(✓)	225'	(✓)	No. of Baths	(1)
Precast	(✓)	1250	( )	250'	( )	Dishwasher	( )
		1500	( )	Other		Garbage Grdr.	( )
		Other				Other	

NOTIFY HEALTH DEPARTMENT AT LEAST EIGHT HOURS BEFORE TANK IS TO BE INSPECTED.

Final Inspection 3-16 1973 Approved ( ) Disapproved ( )

Remarks Well 50' ft from system

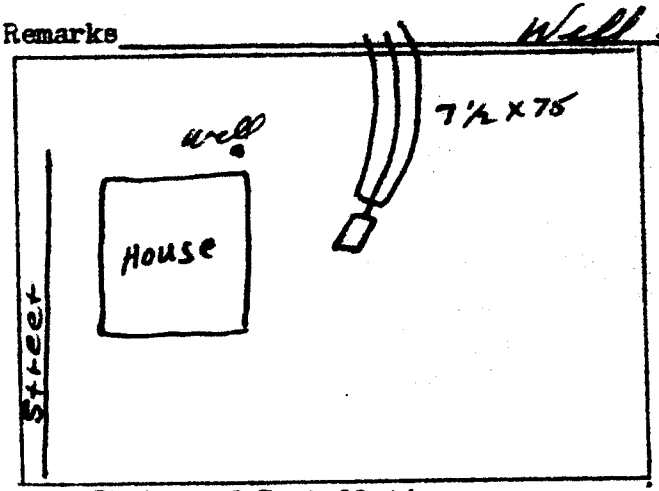

Sketch of Installation

E. A. Stevenson

Sanitarian