IREDELL COUNTY HEALTH DEPARTMENT

(SEPTIC TANK) IMPROVEMENTS PERMIT AND CERTIFICATE OF COMPLETION
(Ground Absorption Sewage Disposal System - G. S. Chapter 130-Article 13C)

OWNER OR CONTRACTOR Hope Bro DATE 12-18-74 PERMIT NO. _____

PHONE: Business _____ Home _____

LOCATION Westover Sub-Division
Winterfield Drive S. R. No. _____


SUBDIVISION NAME Westover LOT NO. 20 SECTION OR BLOCK NO. _____

House (✓) Mobile Home ( ) Business ( ) Other _____

No. Bedrooms 3 No. Bathrooms 2

Garbage Disposal Unit Yes ( ) No (✓)
Auto. Dishwasher Yes ( ) No (✓)
Auto. Wash. Machine Yes (✓) No ( )
Site Suitable Yes (✓) No ( )
Lot Area 15000 sq ft

Character & Porosity of Soil Cecil Clay
Percolation Rate _____
Topography Slight Slope
Depth to Water Table Low
Rock or other impervious formations None

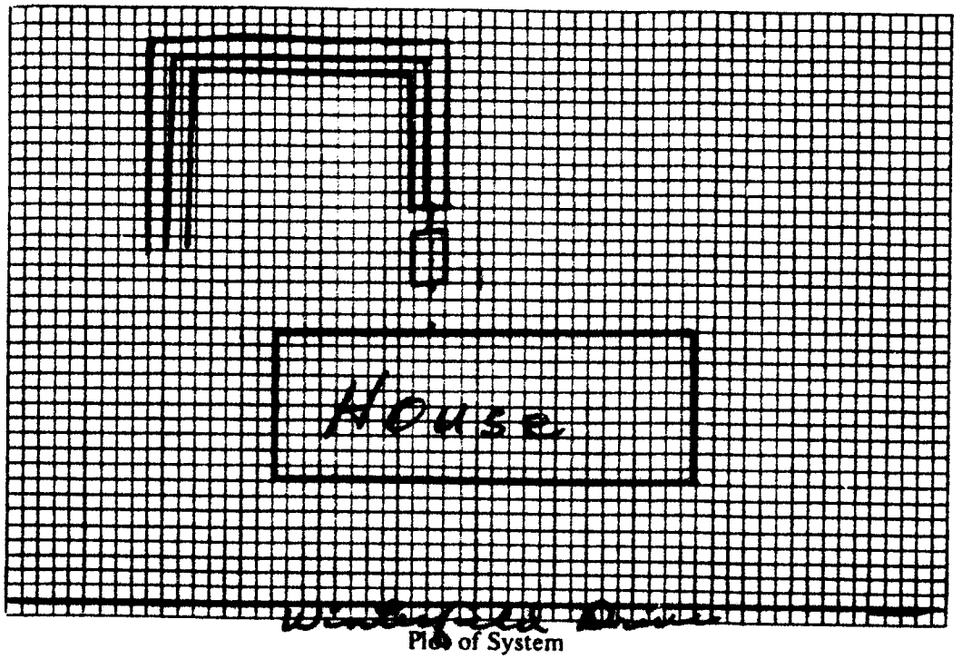

Plan of System

Size of Tank 1000 Gals.
Nitrification Field:
No. of Lines 3
Sq. Ft. 900 Linear Ft. 300
Depth of Stone in Lines 10"
Water Supply: Individual ( )
Pubiic (✓)

Installed by Hope Bro

IMPROVEMENTS PERMIT BY _____

COMMENTS: _____

CERTIFICATE OF COMPLETION BY E. A. Stutenson DATE 12-18-74

CONSTRUCTION MUST COMPLY WITH ALL OTHER APPLICABLE STATE AND LOCAL REGULATIONS.

Health Dept. Copy: White Inspection Dept. Copy: Yellow Sanitarian's Copy: Pink Owner's Copy: Gold