IREDELL COUNTY HEALTH DEPARTMENT

Statesville Phone TR 3-7271 Mooresville Phone No. 664-5281

PERMIT TO INSTALL SEPTIC TANK

Permit No. ____ Permit Date 4-3 1973

Owner Hope Bro Address Statesville, NC

Installed By Hope Bro Address Statesville NC


Location of Property Westminster Drive to Rd # 1636 T.R. into Westover Development, T.L. on Winterfield Rd. House on L. Lot # 24

Tank		Capacity		Length of Lines		Fixtures	
Block	( )	1000	(✓)	225'	( )	No. of Baths	(1½)
Precast	(✓)	1250	( )	250'	( )	Dishwasher	( )
		1500	( )	Other 300 900 sq ft		Garbage Grdr.	( )
		Other ____				Other ____	

NOTIFY HEALTH DEPARTMENT AT LEAST EIGHT HOURS BEFORE TANK IS TO BE INSPECTED.

Final Inspection 4-3 1973 Approved (✓) Disapproved ( )

Remarks Community Water

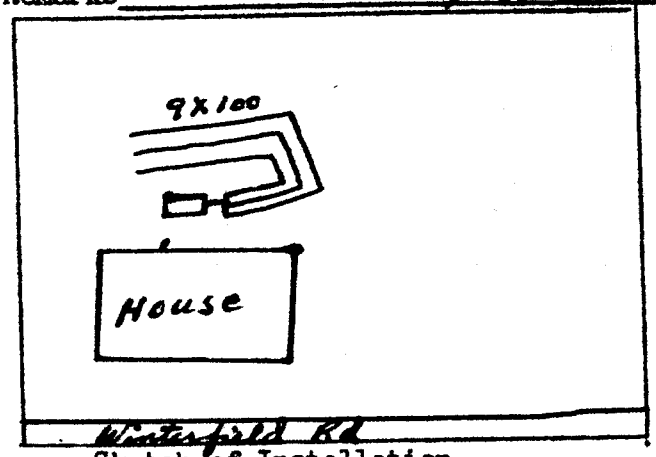

Sketch of Installation

E. A. Stevenson

Sanitarian