IREDELL COUNTY HEALTH DEPARTMENT

Statesville Phone TR 3-7271 Mooresville Phone NO 3-1271

PERMIT TO INSTALL SEPTIC TANK

Permit NO. _____ Permit Date May 5 1960

Owner Jerry Hager Belden Address Bypass

Installed By C Drake Address R 7.


Location of Property Right on bypass of Hickory Hwy before 3rd Creek. 1st trailer on left 2 block.

Tank		Capacity		Length of Lines		Fixtures	
Block	( )	800	( )	150'	( )	No. of Baths	(2)
Precast	(✓)	900	(✓)	175'	( )	Dishwasher	( )
		1000	( )	200'	( )	Garbage Grdr.	( )
Lock		1100	( )	225'	( )	Auto-Washer	(✓)
		1200	( )	250'	( )	Other	
		Other		Other 240			

NOTIFY HEALTH DEPARTMENT AT LEAST EIGHT HOURS BEFORE TANK IS TO BE INSPECTED.

Final Inspection 5-5 1960 Approved ( ) Disapproved ( )

Remarks Septage. Well 50' Very steep 4ft dam.

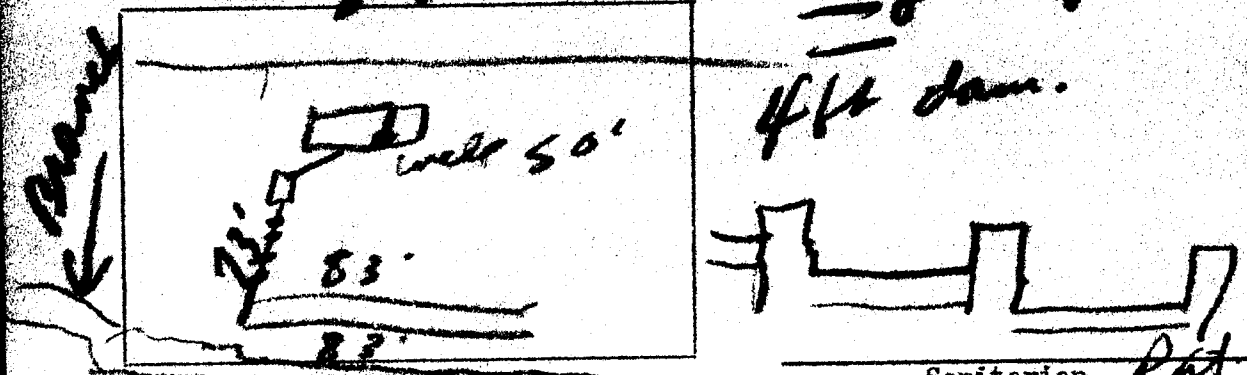

Sketch of Installation

Sanitarian Pat