IREDELL COUNTY HEALTH DEPARTMENT

Statesville Phone TR 3-7271 Mooresville Phone NO 3-1271

PERMIT TO INSTALL SEPTIC TANK

Permit NO. _____ Permit Date July 24 1963

Owner Hope Bros. Elden Address old by pass

Installed By C Hoke Address _____


Location of Property R on old by pass before 3rd creek on Hickory Hwy. 3rd on left.

Tank		Capacity		Length of Lines		Fixtures	
Block	( )	800	( )	150'	( )	No. of Baths	(2)
Precast	(✓)	900	( )	175'	( )	Dishwasher	( )
		1000	(✓)	200'	( )	Garbage Grdr.	( )
		1100	( )	225'	(✓)	Auto-Washer	(✓)
		1200	( )	250'	( )	Other	_____
		Other	_____	Other	_____		

NOTIFY HEALTH DEPARTMENT AT LEAST EIGHT HOURS BEFORE TANK IS TO BE INSPECTED.

Final Inspection 7-24 1963 Approved (✓) Disapproved ( )

Remarks Well 100'

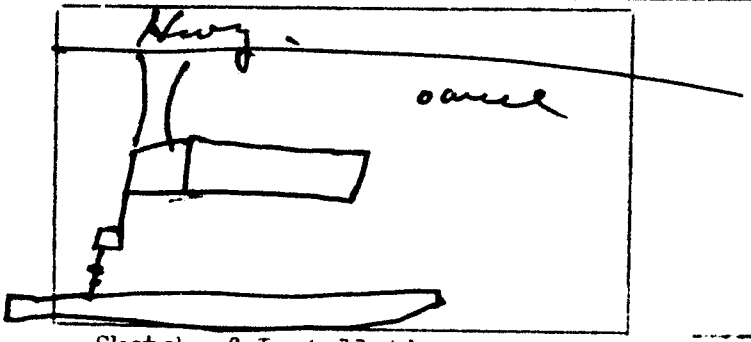

Sketch of Installation

RL

Sanitarian