IREDELL COUNTY HEALTH DEPARTMENT - *ENVIRONMENTAL HEALTH* ☐ STATESVILLE OFFICE 704-878-5305 ☐ MOORESVILLE OFFICE 704-664-5281

IMPROVEMENT PERMIT / AUTHORIZATION TO CONSTRUCT / OPERATION PERMIT / EXISTING SYSTEM INSPECTION

PERMIT # R40018 PIN # 4724-36-1661 DATE 23 February 2011

OWNER Jada Thompson APPLICANT: PHONE: Home/Cell # (704) 450-2752 Business # (704) 871-9113

SITE ADDRESS 3227 Journey Ave. OWNER / APPLICANT ADDRESS

SITE DIRECTIONS Bristol Rd. TR Westminster Rd. TR Journey Ave. 2nd House on left past Shal Rd

SUBDIVISION BLOCK / SECTION LOT # LOT AREA DESIGN FLOW 360 g.p.d. L.T.A.R. 0.3 g/ft²/d

Septic Tank Exist. Gallons: STB Date

Pump Tank 1000 Gallons: PT 145 Date

Pump Make Zoeller Model N152-13 Serial # 0.4HP

No. Nitrification Fields: 1 No. Lines 6 Linear Feet 300

Trench Width 36" Max. Trench Bottom Depth 36" Gravel Depth NA

☐ New System ☑ Repair ☐ Expansion System Type I II (III) IV V VI

System Description:

Repair System Description: 25% Reduction / Pressure manifold

Maintenance Agreement Required ☐ YES ☑ NO

☐ GRAVITY ☑ PRESSURE

☑ Residence No. Bedrooms 3

☐ Business No. Persons

☐ Other No. Employees


☐ Slab ☐ Crawl Space

☑ Basement w/plumbing ☐ Basement w/o plumbing


Water Supply: ☐ Private ☑ Public ☐ Community

Comments / Conditions: Remove tree stumps / Keep 5' from prop. lines. / Risers on PT

INITIAL SITE SKETCH

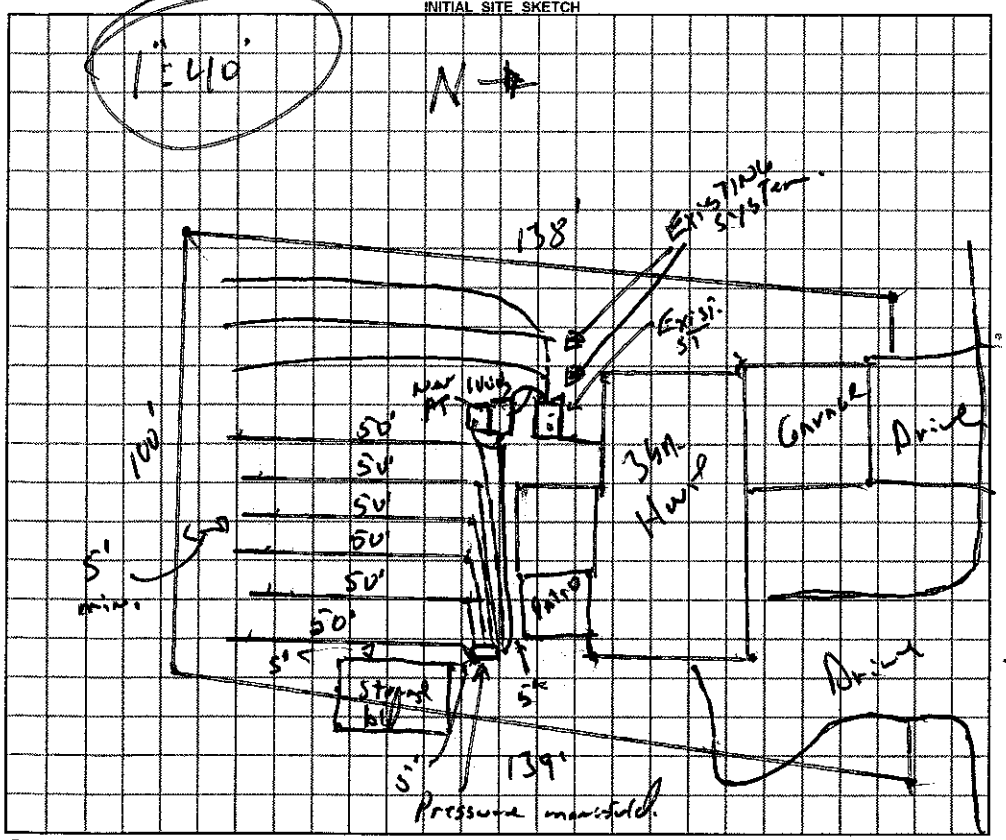

AS BUILT SKETCH

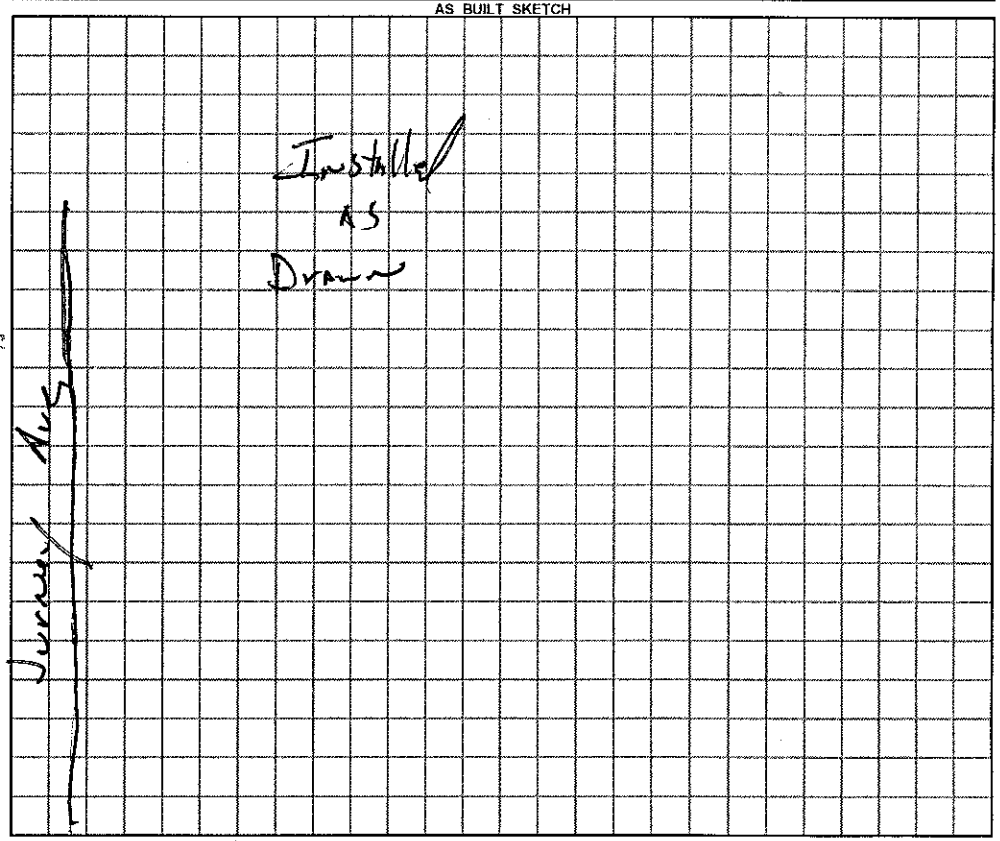

Permit can be suspended or revoked if any false information is supplied toward securing the permit / any unauthorized changes are made to the site / any unauthorized changes are made in the installation of the system.

☐ ***IMPROVEMENT PERMIT*** with plat valid without expiration. ☑ ***IMPROVEMENT PERMIT*** with plat valid ~~without expiration~~ 60 mo. ☐ ***AUTHORIZATION TO CONSTRUCT*** valid for period equal to IMPROVEMENT PERMIT--not to exceed 60 mo.

Owner / Applicant Signature: Jada Thompson Date 3-1-11

IMPROVEMENT PERMIT by: REHS Date 23 Feb. 11

AUTHORIZATION TO CONSTRUCT by: REHS Date 23 Feb. 11

YOU SHOULD CONTACT A LOCATOR SERVICE PRIOR TO ANY EXCAVATION

Installed by: Kevin Boles

OPERATION PERMIT by: REHS Date 25 April 11

Existing System Inspected by: REHS Date

White Copy – Environmental Health YELLOW COPY (Final) Owner / Applicant PINK COPY (Initial) Owner / Applicant