IREDELL COUNTY HEALTH DEPARTMENT

Statesville Phone TR 3-7271 Mooresville Phone NO 3-1271

PERMIT TO INSTALL SEPTIC TANK

Permit No. 12 Permit Date _____ 19__

Owner Hoke Bro Address Statesville N C

Installed By Hoke Bro Address Statesville N C


Location of Property Out Westminster Drive Turn On Road # 1636 Brick house on Right Lot # 8

Tank		Capacity		Length of Lines		Fixtures	
Block	( )	1000	(✓)	225'	(✓)	No. of Baths	( )
Precast	(✓)	1250	( )	250'	( )	Dishwasher	( )
		1500	( )	Other _____		Garbage Grdr.	( )
		Other _____				Other _____	

NOTIFY HEALTH DEPARTMENT AT LEAST EIGHT HOURS BEFORE TANK IS TO BE INSPECTED.

Final Inspection 4-21 19 72 Approved (✓) Disapproved ( )

Remarks City Water (Lines much too deep Top of tank 2½ ft under ground - lines are about 6 ft underground. Due to Slant out.

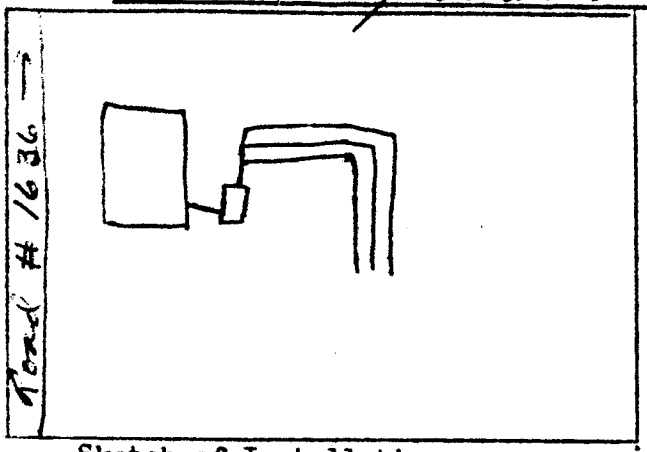

Sketch of Installation

E. G. Stevenson

Sanitarian