IREDELL COUNTY HEALTH DEPARTMENT - *ENVIRONMENTAL HEALTH* ☒ STATESVILLE OFFICE 704-878-5305 ☐ MOORESVILLE OFFICE 704-664-5281

IMPROVEMENT PERMIT / AUTHORIZATION TO CONSTRUCT / OPERATION PERMIT / EXISTING SYSTEM INSPECTION

PERMIT # Repair PIN # 4724316452 8 DATE 10-5-10

OWNER James + Marie Setzer APPLICANT: same PHONE: Home/Cell # 704 873-4978 Business #

SITE ADDRESS 3223 Jurney Rd. OWNER / APPLICANT ADDRESS same

SITE DIRECTIONS Hwy 20 W, (R) on Westminster, (L) on Jurney, lot on Left

SUBDIVISION Westover BLOCK / SECTION LOT # 11 LOT AREA DESIGN FLOW 360 L.T.A.R. Ex

Septic Tank 1500 Gallons: STB Date
Pump Tank Gallons: P T Date
Pump Make Model Serial #
No. Nitrification Fields: Ex No. Lines Ex Linear Feet Ex
Trench Width Ex Max. Trench Bottom Depth Ex Gravel Depth Ex


☐ New System ☒ Repair ☐ Expansion System Type I II (III) IV V VI
System Description:
Repair System Description: Tank Replacement
Maintenance Agreement Required ☐ YES ☒ NO
☒ GRAVITY ☐ PRESSURE

☒ Residence No. Bedrooms 3
☐ Business No. Persons
☐ Other No. Employees
☐ Slab ☒ Crawl Space
☐ Basement w/plumbing ☐ Basement w/o plumbing

Water Supply
☐ Private
☒ Public
☐ Community

Comments / Conditions

INITIAL SITE SKETCH

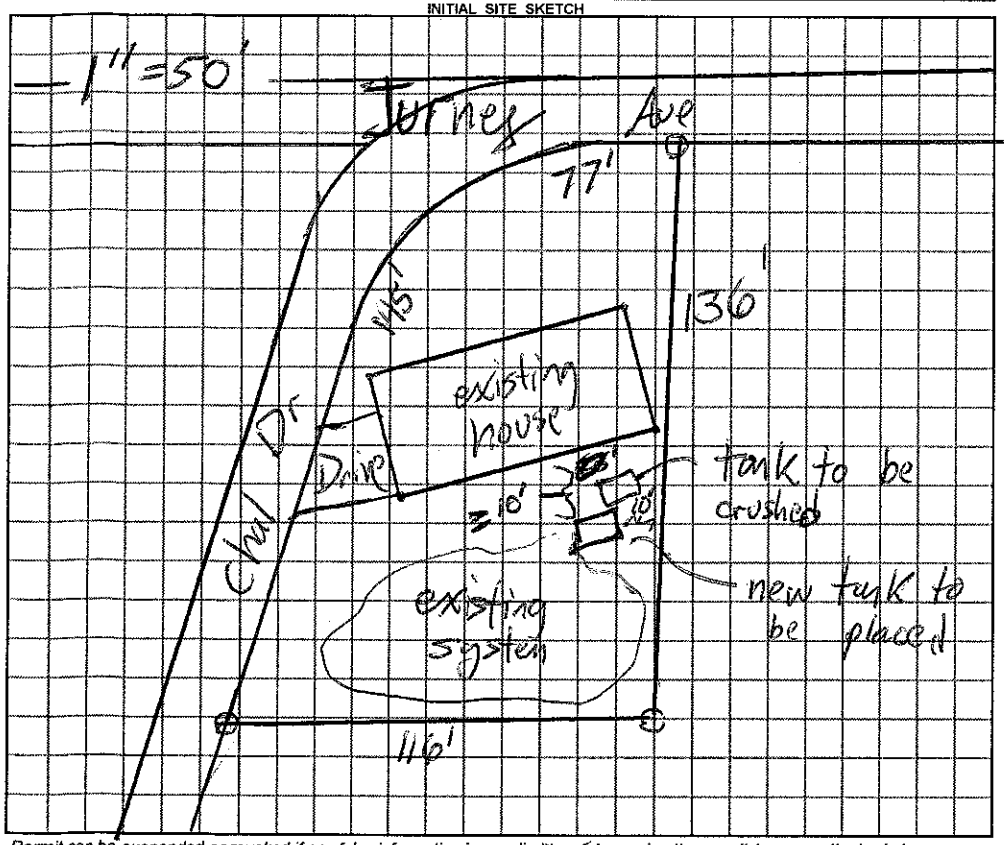

AS BUILT SKETCH

Permit can be suspended or revoked if any false information is supplied toward securing the permit / any unauthorized changes are made to the site / any unauthorized changes are made in the installation of the system.

☐ *IMPROVEMENT PERMIT* with plat valid without expiration. ☒ *IMPROVEMENT PERMIT* ~~with plat valid without expiration~~ site plan for 60 mos. ☐ *AUTHORIZATION TO CONSTRUCT* valid for period equal to IMPROVEMENT PERMIT–not to exceed 60 mo.

Owner / Applicant Signature: Date 10-6-10 Installed by: A-1 Backhoe

IMPROVEMENT PERMIT by: REHS Date 10-5-10

AUTHORIZATION TO CONSTRUCT by: REHS Date 10-5-10

OPERATION PERMIT by: REHS Date 10-8-10

Existing System Inspected by: REHS Date

YOU SHOULD CONTACT A LOCATOR SERVICE PRIOR TO ANY EXCAVATION

White Copy – Environmental Health YELLOW COPY (Final) Owner / Applicant PINK COPY (Initial) Owner / Applicant