Permit # 11529 This permit voids previously issued permit dated 10/24/02

DELL COUNTY HEALTH DEPARTMENT

STATESVILLE 704-878-5305 (C) MOORESVILLE 704-664-5281

IMPROVEMENT PERMIT / AUTHORIZATION TO CONSTRUCT / OPERATION PERMIT / EXISTING SYSTEM INSPECTION

APP'L# City of Statesville PIN# 4724-36-5216 DATE 10/29/03

APP'L OR CONTRACTOR Pat Bass PHONE: Business — Home (704) 873-5742

ADDRESS 709 Winterfield Road Statesville, N.C. 28677

LOCATION US Hwy 70 W (R) on Westminster Drive, 3rd road on left (CHASE DRIVE), lot on left

SUBDIVISION — BLOCK / SECTION LOT LOT AREA 1.08 Acres SITE CLASS 1/5 DESIGN FLOW 480 L.T.A.R. .30

Tank: 1,000 Gallons; STB 1007 Date 12-1-03

Tank: Gallons; PT Date

Make: Model Serial No.

Location Field: No Fields 1 Square Feet Est. to 1200 Linear Feet 400

Lines 4 Trench Width 36" Max Trench Bottom Depth 32" Gravel Depth N/A

[X] New System [ ] Repair System Type: I, II, (III), IV, V, VI

System Description: Gravity, 25% Reduction

Repair System Description: Cut-in, Pump, LP panel

Maintenance Agreement Required: [ ] Yes [X] No

[X] House/Mod. Home No. Bedrooms 4

[ ] Mobile Home No. Bathrooms

[ ] Business No. Employees

[ ] Other


[ ] Slab [ ] Crawl Space [X] Basement w/plumbing [ ] Basement wo/plumbing

Water Supply: [ ] Individual [ ] Public [ ] Community


Comments/Conditions: (1) Keep well 100ft from Septic System (2) Install Lines on Contour (3) maintain proper setbacks Remove Existing Litter Tank on Crest property

Comments/Conditions: (1) SEPTIC TANK WITH MARKER INSTALLED USING "INFITE" FILTER (2) SYSTEM INSTALLED AS SHOWN WITH PRIOR HEALTH DEPARTMENT APPROVAL — USING 40 FEET FLOW SECTIONS

INITIAL SITE SKETCH Scale 1" = 50'

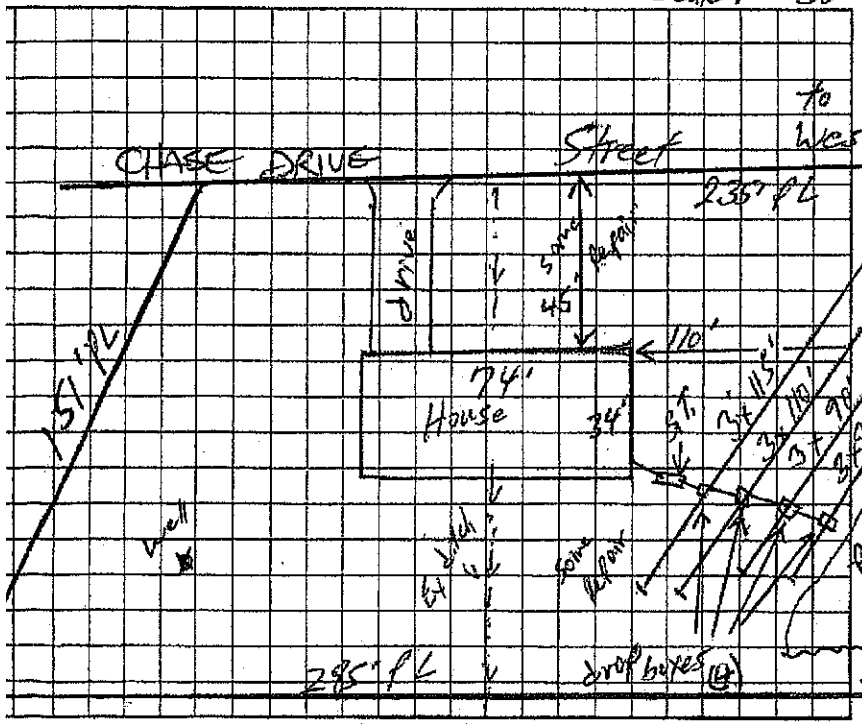

AS BUILT SKETCH

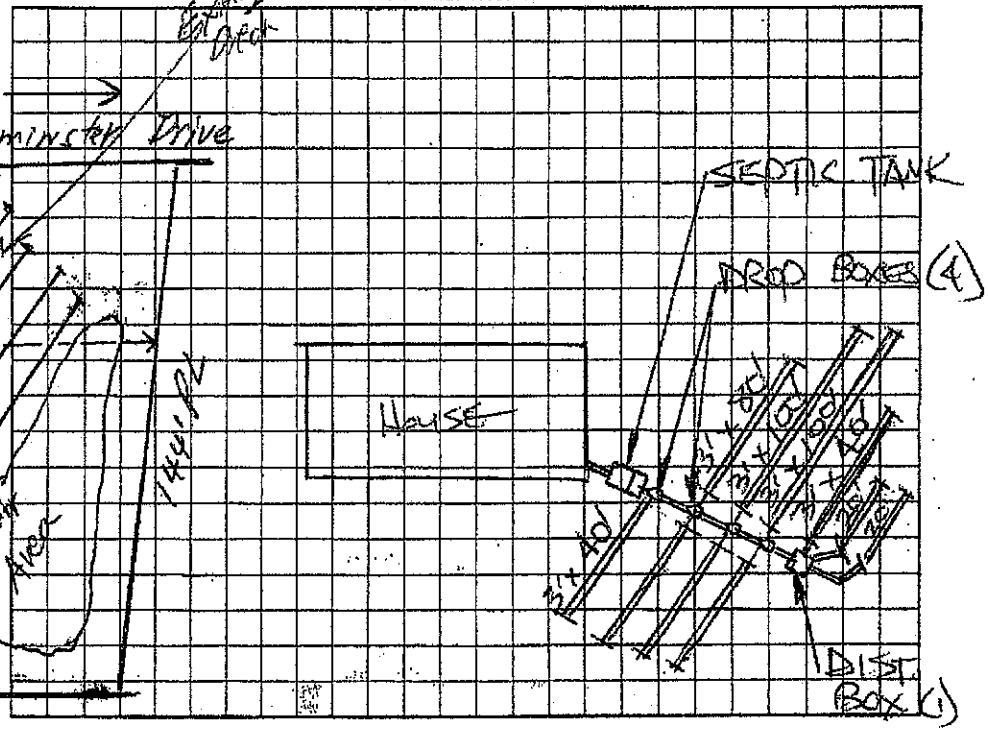

Permit can be suspended or revoked if any false information is supplied toward securing the permit/any unauthorized changes are made to the site/any unauthorized changes are made in the installation of the system. Improvement Permit with plat valid without expiration. Improvement Permit with site plan valid for sixty months. Authorization to Construct is valid for a period equal to that of Improvement Permit – not to exceed sixty months.

William K. Shuford agent date 10/29/03

Improvement Permit by: William O. Johnson date 10/29/03

Authorization to Construct by: William O. Johnson date 10/29/03

Installed by: JAMES HUDLER

Operation Permit by: STEVE HENDRICK date 3-30-04

Existing System Inspection by: date

HEALTH DEPT. COPY: WHITE OWNER COPY (FINAL): YELLOW OWNER COPY (INITIAL): PINK