Permit # 114529 This permit voids previously issued permit dated 10/24/02

IREDELL COUNTY HEALTH DEPARTMENT

STATESVILLE 704-878-5305 (C1) MOORESVILLE 704-664-5281

IMPROVEMENT PERMIT / AUTHORIZATION TO CONSTRUCT / OPERATION PERMIT / EXISTING SYSTEM INSPECTION

PERMIT# City of Statesville PIN# 4724-36-5216 DATE 10/29/03

OWNER OR CONTRACTOR Pat Bass PHONE: Business — Home (704) 873-5142

ADDRESS 709 Winterfield Road Statesville N.C. 28677

LOCATION US Hwy 70 W, (R) on Westminster Drive, 3rd road on left (CHASE DRIVE), 1st lot on left

SUBDIVISION — BLOCK / SECTION ____ LOT ____ LOT AREA 1.08 Acres SITE CLASS. P5 DESIGN FLOW 480 L.T.A.R. .30

Septic Tank: 1,000 Gallons; STB 1007 Date 12-2-03
Pump Tank: ____ Gallons; PT ____ Date ____
Pump Make: ____ Model ____ Serial No. ____
Nitrification Field: No Fields 1 Square Feet Earth to 1200 Linear Feet 400
No Lines 4 Trench Width 36" Max Trench Bottom Depth 32" Gravel Depth N/A

☒ New System ☐ Repair System Type: I, II, (III) IV, V, VI
System Description: Gravity 25% Reduction
Repair System Description: Orenco Pump LP panel
Maintenance Agreement Required: ☐ Yes ☒ No


☒ House/Mod. Home No. Bedrooms 4
☐ Mobile Home No. Bathrooms ____
☐ Business No. Employees ____
☐ Other ____
☐ Slab ☐ Crawl Space ☒ Basement w/plumbing ☐ Basement wo/plumbing

Water Supply: ☐ Individual ☐ Public ☐ Community


Comments:/Conditions: (1) Keep well 100ft from Septic System (2) Install lines on Contour (3) Maintain proper setbacks (4) Remove Existing Litter that crosses property.

Comments:/Conditions: (1) SEPTIC TANK WITH MARKER INSTALLED USING "TUFFTITE" FILTER (2) SYSTEM INSTALLED AS SHOWN WITH PRIOR HEALTH DEPARTMENT APPROVAL — USING 40 FEET LF FLOW SECTIONS

INITIAL SITE SKETCH Scale 1" = 50'

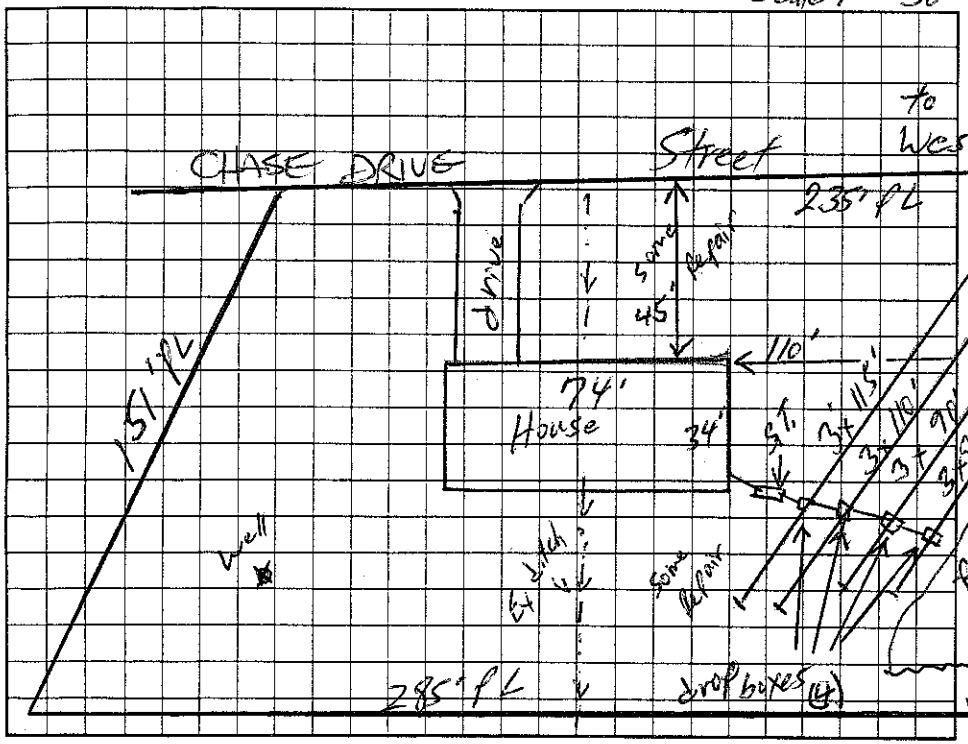

AS BUILT SKETCH

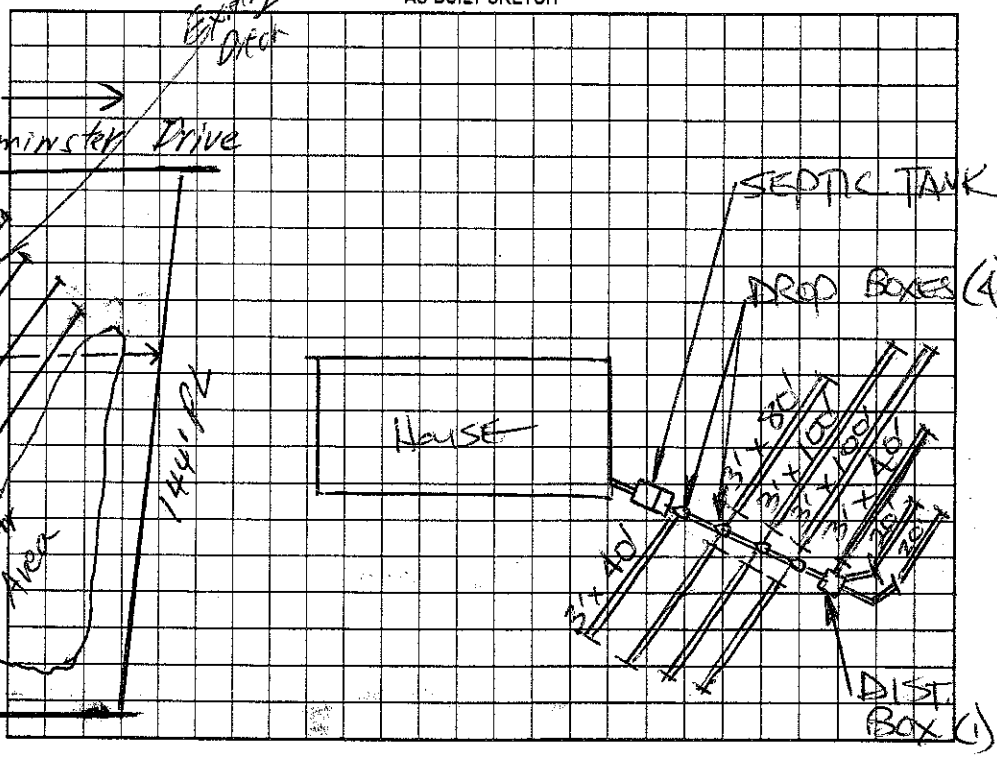

Permit can be suspended or revoked if any false information is supplied toward securing the permit/any unauthorized changes are made to the site/any unauthorized changes are made in the installation of the system. Improvement Permit with plat valid without expiration. Improvement Permit with site plan valid for sixty months. Authorization to Construct is valid for a period equal to that of Improvement Permit – not to exceed sixty months.

Signed: William K. Shuell agent date 10/23/03
Improvement Permit by: William O. Johnson date 10/29/03
Authorization to Construct by: William O. Johnson date 10/29/03

Installed by: JAMES HUDLER
Operation Permit by: STEVE HEDRICK date 3-30-04
Existing System Inspection by: ____ date ____

HEALTH DEPT. COPY: WHITE OWNER COPY (FINAL): YELLOW OWNER COPY (INITIAL): PINK