IREDELL COUNTY HEALTH DEPARTMENT

Statesville Phone TR 3-7271 Mooresville Phone No. 664-5281

PERMIT TO INSTALL SEPTIC TANK

Permit No. 95 Permit Date 12-4 1972

Owner Jeff Horne Jr. Address Statesville N.C.

Installed By York Rusty Address Stony Point N.C.


Location of Property Westminster Drive to Turnup Ave (#1408) T.R. 2nd House on L.

Tank		Capacity		Length of Lines		Fixtures	
Block	( )	1000	(✓)	225'	(✓)	No. of Baths	(1½)
Precast	(✓)	1250	( )	250'	( )	Dishwasher	(–)
		1500	( )	Other		Garbage Grdr.	(–)
		Other				Other	

NOTIFY HEALTH DEPARTMENT AT LEAST EIGHT HOURS BEFORE TANK IS TO BE INSPECTED.

Final Inspection 12-4 1972 Approved (✓) Disapproved ( )

Remarks No Well on Property at time of inspection

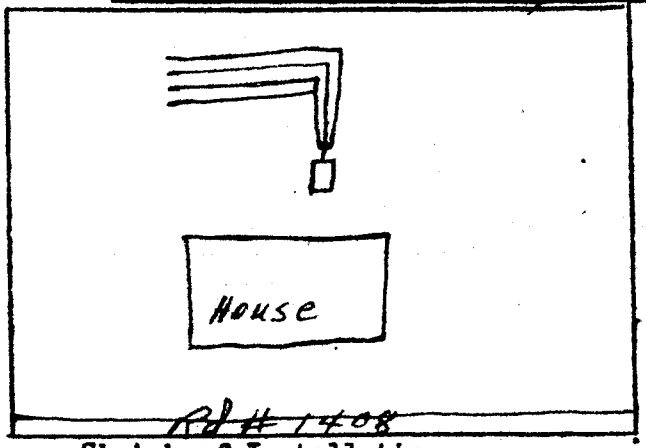

Sketch of Installation

E. A. Stevenson

Sanitarian