IREDELL COUNTY HEALTH DEPARTMENT

Statesville Phone TR 3-7271 Mooresville Phone No. 664-5281

PERMIT TO INSTALL SEPTIC TANK

Permit No. 96 Permit Date 12-4 1971

Owner Larry Jenkins Sdv. (Jimmy Pellett) Address Statesville N.C.

Installed By Lackey Bro. Address Stony Point N.C.


Location of Property Corner of Westminster Drive and Road 1636

Tank		Capacity		Length of Lines		Fixtures	
Block	( )	1000	(✓)	225'	( )	No. of Baths	(1½)
Precast	(✓)	1250	( )	250'	( )	Dishwasher	(✓)
		1500	( )	Other 240		Garbage Grdr.	(—)
		Other				Other	

NOTIFY HEALTH DEPARTMENT AT LEAST EIGHT HOURS BEFORE TANK IS TO BE INSPECTED.

Final Inspection 12-4 1971 Approved (✓) Disapproved ( )

Remarks Community Water

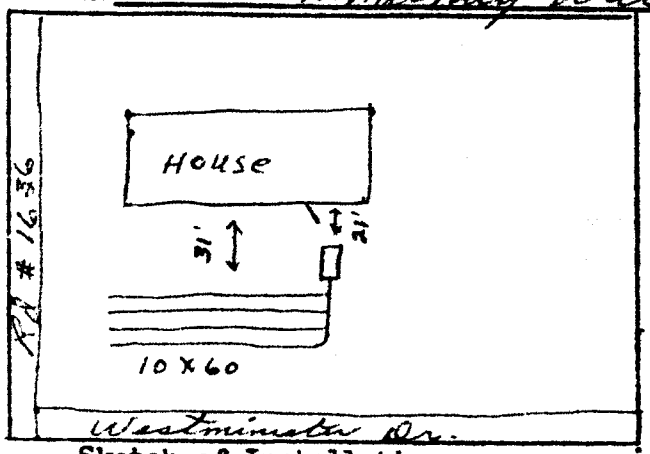

Sketch of Installation

This system was put in the best possible place. But was put in filled dirt and could possibly give trouble later.

E. G. Stevenson

Sanitarian