Pd. 175.00 2/8/96 M.B.

60210

IREDELL COUNTY HEALTH DEPARTMENT

STATESVILLE 704-878-5305 MOORESVILLE 704-664-5281

IMPROVEMENT PERMIT / CERTIFICATE OF COMPLETION / OPERATION PERMIT / EXISTING SYSTEM INSPECTION

PROPERTY DESCRIPTION NO CITY DATE 1-29-96 TAX MAP NO 6L-2-A-65, 70, & 74 Watershed: Yes ✓No

OWNER OR CONTRACTOR JEFFREY L. & AUSH BUNTON PHONE: Business Home 873-0925

ADDRESS 3343 CLIFFWOOD LANE STATESVILLE NC 28677

LOCATION NE 90 IN TL BRISTOL, TR WESTMINSTER, TR CLIFFWOOD, 3RD HOUSE ON LEFT

SUBDIVISION MILLER ADDITION WESTOVER BLOCK / SECTION LOT 66-75 LOT AREA 200 x 300 SITE CLASS PS DESIGN FLOW 360 L T A R 0.30 GPD/FT²

Septic Tank: 1000 Gallons: STB Date

Pump Tank: 1000 Gallons: PT Date

Pump Make: Model ORENCO Serial No

Nitrification Field: No Fields 1 Square Feet 1200 Linear Feet 500

No Lines 4 Trench Width 36" Max Trench Bottom Depth 24-30" Gravel Depth N/A

✓New System Repair System Type I II III IV V

System Description PUMP-FED CHAMBERS

Repair System Description PUMP-FED CHAMBERS

Maintenance Agreement Required Yes ✓No

✓House/Mod Home No Bedrooms 3

Mobile Home No Bathrooms

Business No Employees

Other


Slab Crawl Space ✓Basement w/plumbing Basement wo/plumbing

Water Supply: ✓Individual Community Public WELL

Comments (1) KEEP SYSTEM MINIMUM 100' FROM WELL (2) USE 50 CHAMBERS IN FOUR LINES AS SHOWN (3) SEE ATTACHED SHEETS FOR PUMP & PRESSURE MANIFOLD REQUIREMENTS

Comments DRAINFIELD INSPECTED 5-14-96 - OK

INITIAL SITE SKETCH

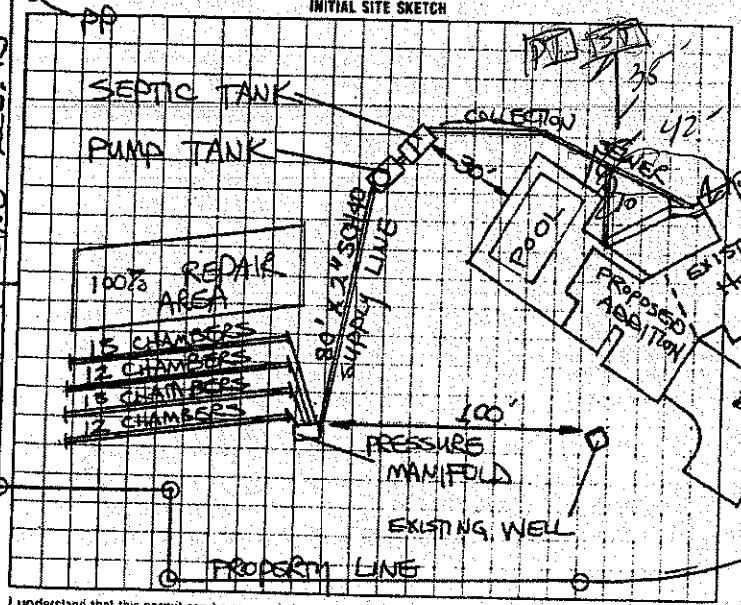

AS BUILT SKETCH

I understand that this permit can be suspended or revoked if any false information is supplied toward securing the permit, any unauthorized changes are made to the site/any unauthorized changes are made in the installation of the system

AUTHORIZATION TO CONSTRUCT IS VALID FIVE (5) YEARS FROM DATE OF ISSUANCE. IMPROVEMENT PERMIT HAS NO EXPIRATION DATE.

Signed Jeffrey L Bunton 2/8/96

Improvement Permit by STEVE HEDRICK date 1-29-96 Installed by BARRY SIGMON

AUTHORIZATION TO CONSTRUCT Existing System Inspection by STEVE HEDRICK date 1-29-96 Certificate of Completion by date

Operation Permit by STEVE HEDRICK date

HEALTH DEPT COPY WHITE | INSPECTION COPY (FINAL) GREEN | OWNER COPY (FINAL) YELLOW | INSPECTION COPY (INITIAL) PINK | OWNER COPY (INITIAL) GOLD