IREDELL COUNTY HEALTH DEPARTMENT

Statesville Office (704) 878-5305 Mooresville Office (704) 660-3625 PERMIT # 20976

IMPROVEMENT PERMIT / AUTHORIZATION TO CONSTRUCT / OPERATION PERMIT / EXISTING SYSTEM

PIN # 4724382243

APPLICANT: Superior Pools APPLICANT ADDRESS: 20315 Knox Rd Cornelius NC

SITE ADDRESS: 3343 Cliffwood Ln Statesville NC 28677 PHONE: 704-896-7665 ALT. PHONE: 704-560-3462


SITE DIRECTIONS: 90 W T/L Bristol T/R Westminster T/R Cliffwood 3rd house on left

SUBDIVISION: Westover Miller Addition SECTION: N/A LOT # 65-77 LOT AREA: 1.671 ac DESIGN FLOW: Ex L.T.A.R.: Ex


Septic Tank	Ex (gal)	STB	Date	☐ New System ☐ Repair ☐ Expansion	System Type: I II ☒ III IV V VI	☒ Residence	No. Bedrooms	Ex	Water Supply
Pump Tank	(gal)	PT	Date	System Description:	Existing	☐ Business	No. Persons	Ex	☒ Private
Pump Make		Model	Serial #	Repair System Description:		☐ Other	No. Employees		☐ Public
# Nitrification Fields	Ex # Lines Ex		Linear Ft: Ex	Maintenance Agreement Required:	☐ YES ☒ NO	☐ Slab	☐ Crawl Space		☐ Community
Trench Width	Ex Max. Trench Bottom Depth Ex			Gravel Depth N/A	☐ GRAVITY ☒ PRESSURE	☒ Basement w/plumbing		☐ Basement w/o plumbing	

Comments / Conditions: All Pools must be ≥ 15' from any part of STS.

INITIAL SITE SKETCH

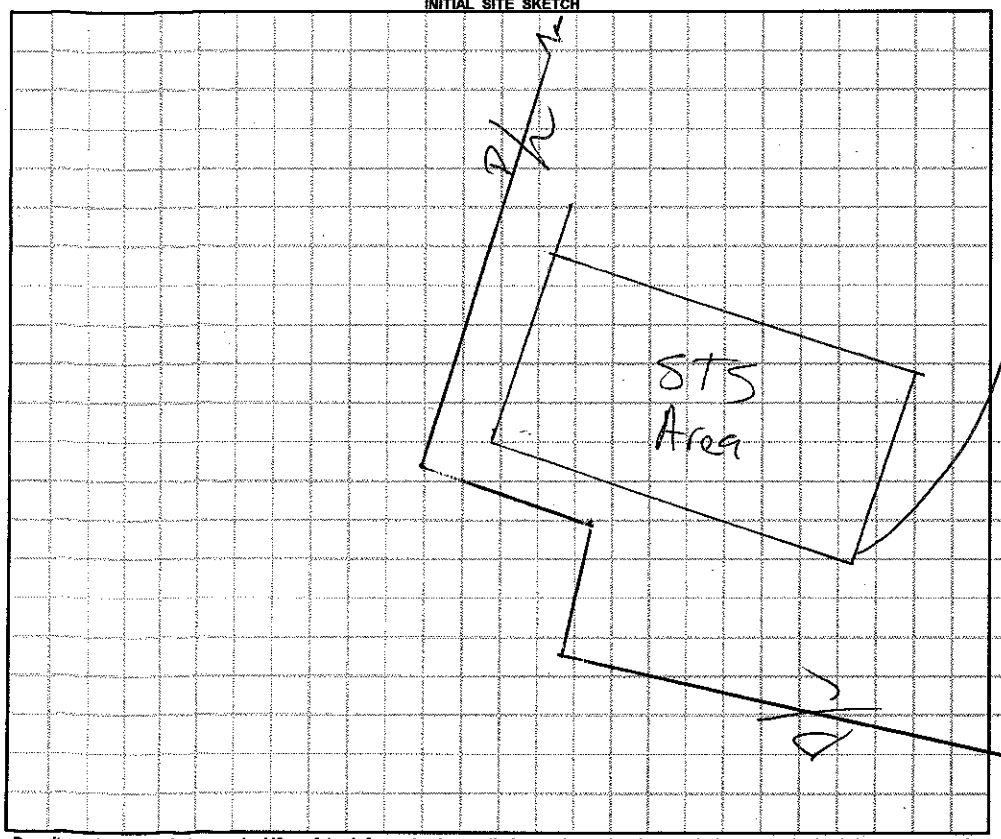

AS BUILT SKETCH

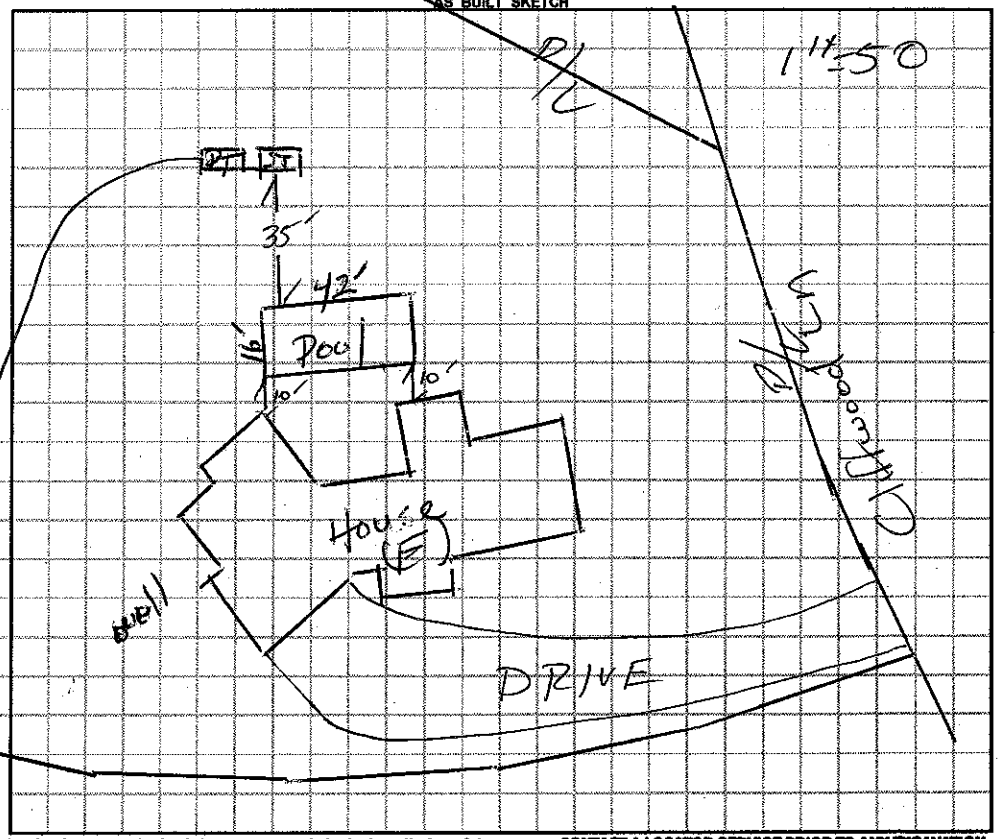

Permit can be suspended or revoked if any false information is supplied toward securing the permit / any unauthorized changes are made to the site / any unauthorized changes are made in the installation of the system. **CONTACT A LOCATOR SERVICE PRIOR TO ANY EXCAVATION**

☐ **IMPROVEMENT PERMIT** *with plat valid without expiration.* ☐ **IMPROVEMENT PERMIT** *with site plan valid for 60 mos.* ☐ **AUTHORIZATION TO CONSTRUCT** *valid for period equal to IMPROVEMENT PERMIT--not to exceed 60 mo.*

Owner / Applicant Signature: [signature] Date: 4-22-15 Installed by:

IMPROVEMENT PERMIT by: Date: OPERATION PERMIT by: Date:

AUTHORIZATION TO CONSTRUCT by: Date: Existing System Inspected by: [signature] Date: 04/15/15

Health Dept. Copy - WHITE Applicant (Final Approval) - YELLOW Applicant (Conditional Approval) - PINK