IREDELL COUNTY HEALTH DEPARTMENT

Statesville Office (704) 878-5305 Mooresville Office (704) 660-3625 PERMIT # 17973

IMPROVEMENT PERMIT / AUTHORIZATION TO CONSTRUCT / OPERATION PERMIT / EXISTING SYSTEM

PIN # 4724389384

APPLICANT: Larry Stroud APPLICANT ADDRESS: 412 Westminster Dr

SITE ADDRESS: 412 Westminster Dr. PHONE: 704-872-1643 ALT. PHONE: N/A

SITE DIRECTIONS: Hwy 90 W TL Bristol Dr. TR Westminster Dr. on right at corner of Westminster & Marcia Ln

SUBDIVISION: Westlowes Miller Addition SECTION: N/A LOT # 17-20 LOT AREA: 1.04 acres DESIGN FLOW: 240 gpd L.T.A.R.: 0.3

Septic Tank Existing (gal) STB Date

Pump Tank (gal) PT Date

Pump Make Model Serial #

Nitrification Fields 1 # Lines 2 Linear Ft: 184

Trench Width 36" Max. Trench Bottom Depth 36" Gravel Depth N/A

☐ New System ☑ Repair ☐ Expansion System Type: I II ☒ IV V VI

System Description:

Repair System Description: 25% Reduction

Maintenance Agreement Required: ☐ YES ☑ NO

☑ GRAVITY ☐ PRESSURE

☑ Residence No. Bedrooms 2

☐ Business No. Persons

☐ Other No. Employees

☐ Slab ☐ Crawl Space

☐ Basement w/plumbing ☑ Basement w/o plumbing

Water Supply

☑ Private


☐ Public

☐ Community

Comments / Conditions: Install a 25% Reduction system on Contour with serial distribution. Relocate Water line, so that it is a minimum of 10' away from all components of septic tank system

- Replace septic tank and/or tee if necessary

INITIAL SITE SKETCH

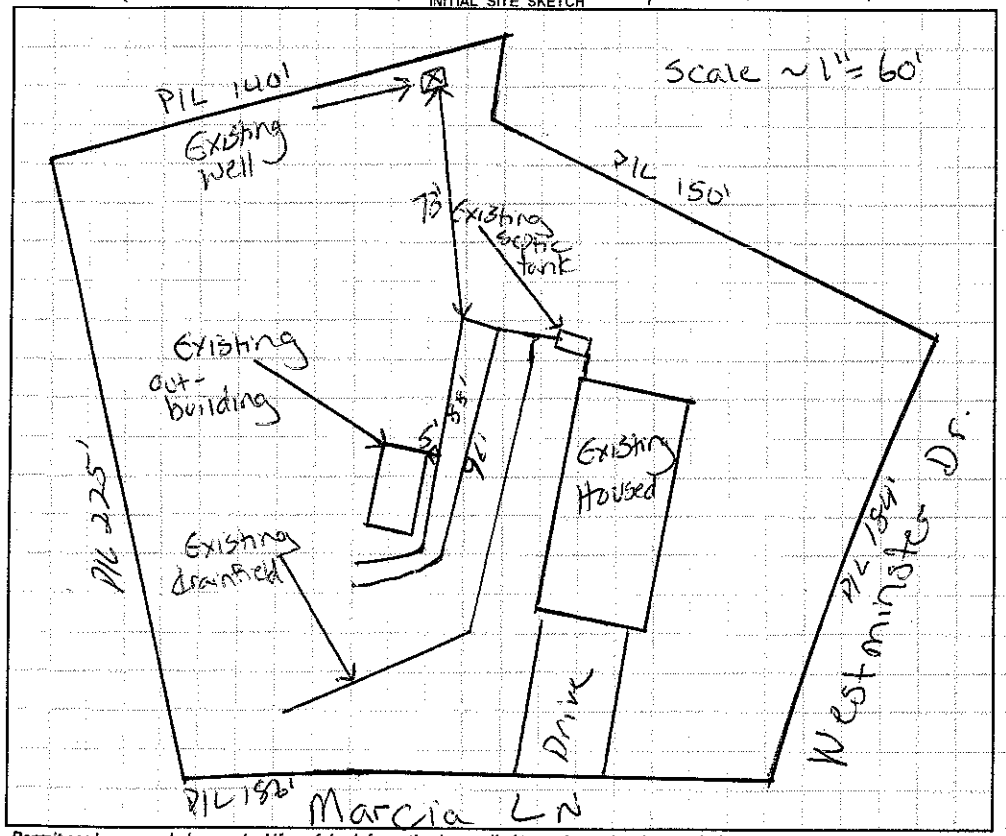

AS BUILT SKETCH

- Quick 4 chambers installed
- Existing line located & backed up with SVC tee.
- Installed as drawn

Permit can be suspended or revoked if any false information is supplied toward securing the permit / any unauthorized changes are made to the site / any unauthorized changes are made in the installation of the system. **CONTACT A LOCATOR SERVICE PRIOR TO ANY EXCAVATION**

☐ **IMPROVEMENT PERMIT** *with plat valid without expiration.* ☑ **IMPROVEMENT PERMIT** *with site plan valid for 60 mos.* ☑ **AUTHORIZATION TO CONSTRUCT** *valid for period equal to IMPROVEMENT PERMIT--not to exceed 60 mo.*

Owner / Applicant Signature: Larry Stroud Date: 4-26-13 Installed by: Younts Grading

IMPROVEMENT PERMIT by: Justin Henderson Date: 4-26-13 OPERATION PERMIT by: Justin Henderson Date: 5-3-13

AUTHORIZATION TO CONSTRUCT by: Justin Henderson Date: 4-26-13 Existing System Inspected by: Date:

Health Dept. Copy - WHITE Applicant (Final Approval) - YELLOW Applicant (Conditional Approval) - PINK