IREDELL COUNTY HEALTH DEPARTMENT

Statesville Phone TR 3-7271 Mooresville Phone NO 3-1271

PERMIT TO INSTALL SEPTIC TANK

Permit NO. _____ Permit Date Jan-9-1962

Owner Carroll Campbell Address Kentwood Park

Installed By C Hoke Address R7


Location of Property out Hickory Hwy. to Kentwood Subdiv. left corner.

Tank	Capacity	Length of Lines	Fixtures
Block ( )	800 ( )	150' ( )	No. of Baths (2)
Precast (✓)	900 ( )	175' ( )	Dishwasher ( )
	1000 (✓)	200' ( )	Garbage Grdr. ( )
each	1100 ( )	225' (✓)	Auto-Washer ( )
	1200 ( )	250' ( )	Other _____
	Other _____	Other _____	

NOTIFY HEALTH DEPARTMENT AT LEAST EIGHT HOURS BEFORE TANK IS TO BE INSPECTED.

Final Inspection Jan 9. 1962 Approved (✓) Disapproved ( )

Remarks well 50' - 5' wide

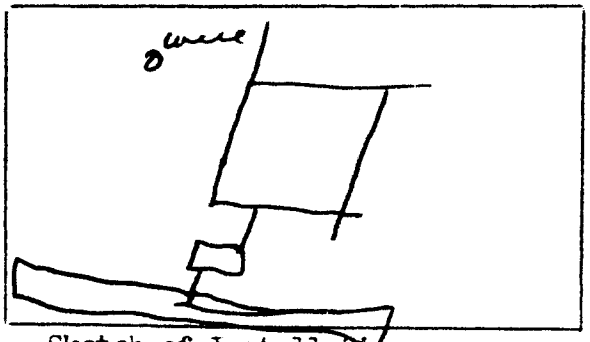

Sketch of Installation

Rut

Sanitarian