IREDELL COUNTY HEALTH DEPARTMENT

Statesville Phone TR 3-7271 Mooresville Phone NO 3-1271

PERMIT TO INSTALL SEPTIC TANK

Permit NO. _____ Permit Date Sept 25 1962

Owner Bird Supply Co Elder Address Mocksville Rd.

Installed By Hoke Address Rte. 7, City


Location of Property 1st ho. on left in tent wood off Hickory Hwy. past Carolina Inn

Tank		Capacity		Length of Lines		Fixtures	
Block	( )	800	( )	150'	( )	No. of Baths	( )
Precast	(✓)	900	( )	175'	( )	Dishwasher	( )
		1000	(✓)	200'	( )	Garbage Grdr.	( )
		1100	( )	225'	(✓)	Auto-Washer	( )
		1200	( )	250'	( )	Other	
		Other		Other			

NOTIFY HEALTH DEPARTMENT AT LEAST EIGHT HOURS BEFORE TANK IS TO BE INSPECTED.

Final Inspection 9-25 1962 Approved (✓) Disapproved ( )

Remarks Well 75' lines 5' wide

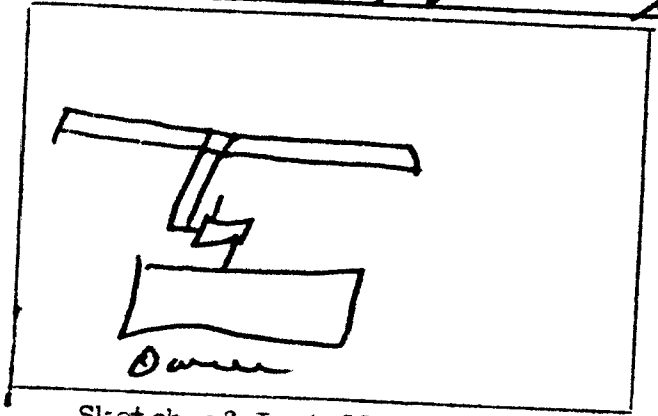

Sketch of Installation

Sanitarian