IREDELL COUNTY HEALTH DEPARTMENT

Statesville Phone TR 3-7271 Mooresville Phone MO 3-1271

PERMIT TO INSTALL SEPTIC TANK

Permit NO. ____ T L Hope Bldr. Permit Date Feb 7 - 1962

Owner Clarence Wooten Address Kentwood Rd

Installed By C Hoke Address R7


Location of Property 1st on left Kentwood.

Tank	Capacity	Length of Lines	Fixtures
Block ( )	800 ( )	150' ( )	No. of Baths (1)
Precast (L)	900 ( )	175' ( )	Dishwasher ( )
Lash	1000 (✓)	200' ( )	Garbage Grdr. ( )
	1100 ( )	225' (✓)	Auto-Washer ( )
	1200 ( )	250' ( )	Other ____
	Other ____	Other ____	

NOTIFY HEALTH DEPARTMENT AT LEAST EIGHT HOURS BEFORE TANK IS TO BE INSPECTED.

Final Inspection Feb 7 1962 Approved (✓) Disapproved ( )

Remarks well 501 - Ckd by Johnson

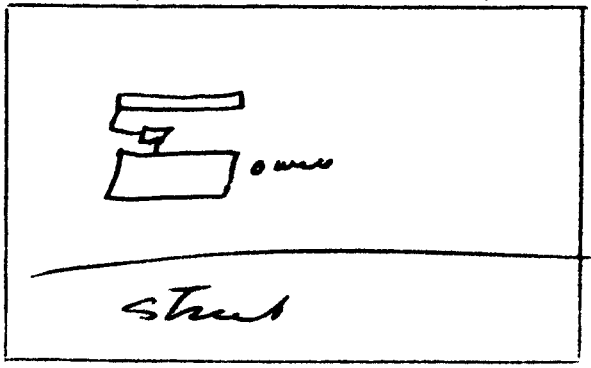

Sketch of Installation

R.H.

Sanitarian