IREDELL COUNTY HEALTH DEPARTMENT

Statesville Phone TR 3-7271 Mooresville Phone NO 3-1271

PERMIT TO INSTALL SEPTIC TANK

Permit NO. _____ Permit Date April 19 1963

Owner Mr. Bobbie Poole Address Statesville

Installed By Roy Lentz Address Statesville


Location of Property corner lot as you enter Kentwood Park on Right

Tank	Capacity	Length of Lines	Fixtures
Block ( )	800 ( )	150' ( )	No. of Baths (1)
Precast ( )	900 ( )	175' ( )	Dishwasher ( )
Pond	1000 (✓)	200' ( )	Garbage Grdr. ( )
	1100 ( )	225' (✓)	Auto-Washer (✓)
	1200 ( )	250' ( )	Other _____
	Other _____	Other _____	

NOTIFY HEALTH DEPARTMENT AT LEAST EIGHT HOURS BEFORE TANK IS TO BE INSPECTED.

Final Inspection 4-19 1963 Approved (✓) Disapproved ( )

Remarks _____

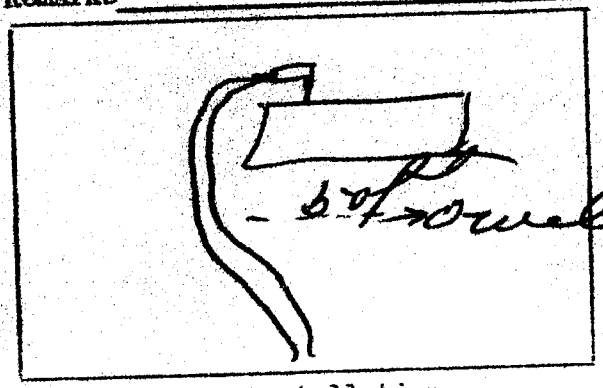

Sketch of Installation

Sanitarian