IREDELL COUNTY HEALTH DEPARTMENT

STATESVILLE 704-878-5305 MOORESVILLE 704-664-5281

IMPROVEMENT PERMIT / AUTHORIZATION TO CONSTRUCT / OPERATION PERMIT / EXISTING SYSTEM INSPECTION

PERMIT# STATESVILLE PIN# 6359 DATE 4-22-99

OWNER OR CONTRACTOR PERRY HARRINGTON PHONE: Business Home 878-9538

ADDRESS 621 OLD FARM, STATESVILLE, NC 28677

LOCATION 4S 70 WEST, TR KENTWOOD DRIVE, 2ND LOT ON RIGHT

SUBDIVISION KENTWOOD BLOCK / SECTION LOT 40 LOT AREA LIMITED SITE CLASS PS DESIGN FLOW 360 L.T.A.R. 0.25 GPD/FT²

Septic Tank: 1000 Gallons; STB 1012 Date 4-19-99

Pump Tank: Gallons; PT Date

Pump Make: Model Serial No.

Nitrification Field: No Fields 1 Square Feet 60 To 1440 Linear Feet 240

No Lines SIX Trench Width 24" Max Trench Bottom Depth 34" Gravel Depth SAND 6"

(I) New System ( ) Repair System Type: I, II, III, IV, V, VI

System Description: GRAVITY-FED PPBPS

Repair System Description: MAX-FEASIBLE, PPBPS

Maintenance Agreement Required: ( ) Yes (✓) No

(✓) House/Mod. Home No. Bedrooms 3

( ) Mobile Home No. Bathrooms 2

( ) Business No. Employees

( ) Other


( ) Slab (✓) Crawl Space ( ) Basement w/plumbing ( ) Basement wo/plumbing

Water Supply: (✓) Individual ( ) Public ( ) Community WELL


Comments/Conditions: ① KEEP SYSTEM MINIMUM 50' FROM WELL, 5' FROM PROPERTY LINE (.1951 (a,b,c-3))
② INSTALL FIFTY-FOUR (54) PPBPS PANELS IN SIX EQUAL LENGTH LINES ON CONTOUR AS FLAGGED

Comments/Conditions:

INITIAL SITE SKETCH SCALE: 1" = 30'

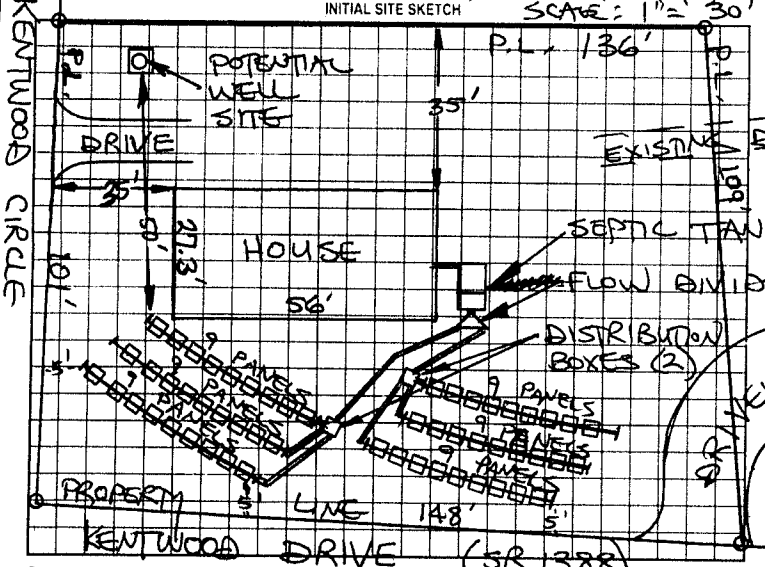

AS BUILT SKETCH

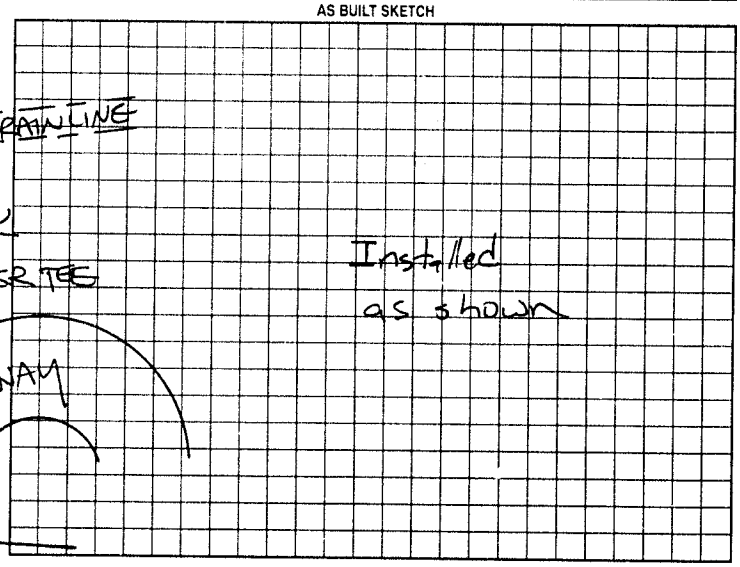

Permit can be suspended or revoked if any false information is supplied toward securing the permit/any unauthorized changes are made to the site/any unauthorized changes are made in the installation of the system. Improvement Permit with plat valid without expiration/Improvement Permit with site plan valid for sixty months. Authorization to Construct is valid for a period equal to that of Improvement Permit - not to exceed sixty months.

Signed: Perry R. Harrington date 4-20-99

Improvement Permit by: STEVE HEDRICK date 4-22-99

Authorization to Construct by: STEVE HEDRICK date 4-22-99

Installed by: A-1 Backhoe

Operation Permit by: Mark Coffey date 5-28-99

Existing System Inspection by: date

HEALTH DEPT. COPY: WHITE OWNER COPY (FINAL): YELLOW OWNER COPY (INITIAL): PINK