IREDELL COUNTY HEALTH DEPARTMENT

STATESVILLE 704-878-5305 MOORESVILLE 704-664-5281

IMPROVEMENT PERMIT / AUTHORIZATION TO CONSTRUCT / OPERATION PERMIT / EXISTING SYSTEM INSPECTION

PERMIT# REPAIR PIN# 4724-43-7265 DATE 3-18-08

OWNER OR APPLICANT COMFORT HOME PROPERTIES PHONE: Business 336-492-2089 Home

ADDRESS 2930 NEWTON DRIVE, STATESVILLE NC 28677

LOCATION US 70 WEST, HOUSE ON RIGHT JUST BEFORE KENTWOOD DRIVE AT # 2930

SUBDIVISION KENTWOOD BLOCK / SECTION LOT 6-9 LOT AREA 100'x140' SITE CLASS. PS DESIGN FLOW 480 L.T.A.R. 0.30 GAD/FT²

Septic Tank: 1000 Gallons; STB 760 Date 12-2-08

Pump Tank: Gallons; PT Date

Pump Make: Model EQ 70 Serial No.

Nitrification Field: No Fields 1 Square Feet 1200 Linear Feet 200

No Lines FOUR Trench Width 24" Max Trench Bottom Depth 36+/- Gravel Depth N/A

☐ New System ☑ Repair ☐ Expansion System Type: I II (III) IV V VI

System Description:

Repair System Description: 50% REDUCTION, GRAVITY

Maintenance Agreement Required: ☐ Yes ☑ No

☑ House/Mod. Home ☐ Mobile Home ☐ Business ☐ Other

No. Bedrooms 4 No. Persons No. Employees


Water Supply: ☐ Individual ☑ Public ☐ Community

☑ Gravity ☐ Pressure ☐ Slab ☑ Crawl Space ☐ Basement w/plumbing ☐ Basement wo/plumbing

Comments/Conditions: ① INSTALL NEW SEPTIC TANK AS SHALLOW AS POSSIBLE. ② INSTALL NEW 50% REDUCTION LINES AS FLAGGED, AS SHALLOW AS POSSIBLE, USING 46 PPBDS PANELS.

Comments:/Conditions: SEPTIC TANK WITH RISER INSTALLED USING RED "Poly Lok" FILTER

INITIAL SITE SKETCH

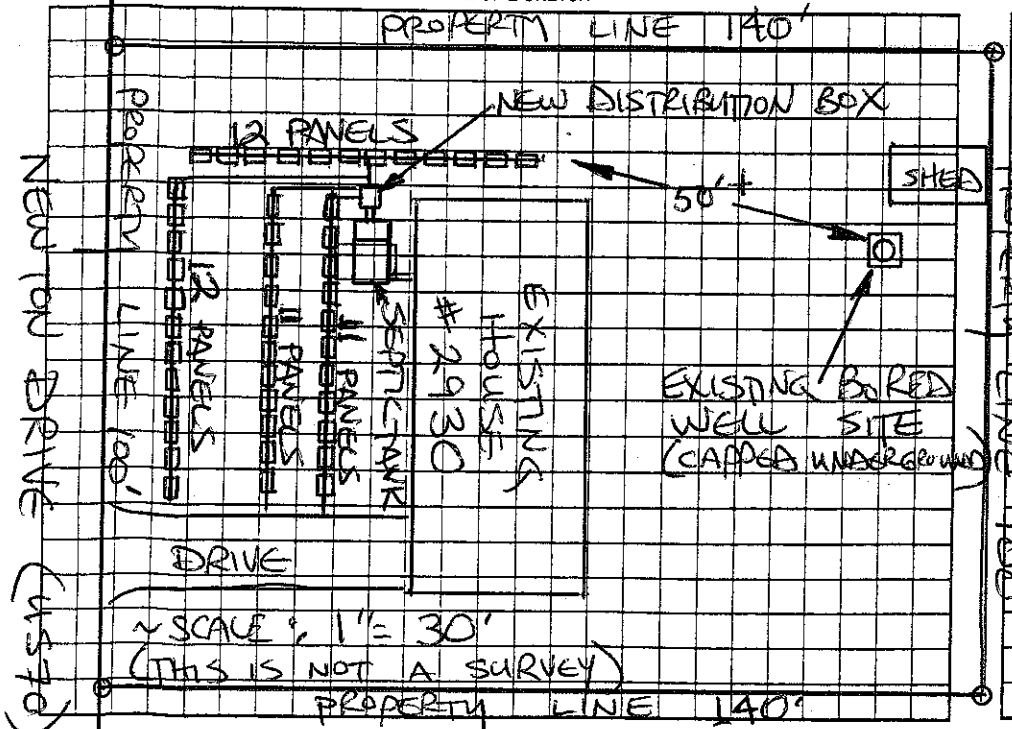

AS BUILT SKETCH

SYSTEM INSTALLED ACCORDING TO INTIAL SITE SKETCH

Permit can be suspended or revoked if any false information is supplied toward securing the permit/any unauthorized changes are made to the site/any unauthorized changes are made in the installation of the system. Improvement Permit with plat valid without expiration ☐ Improvement Permit with site plan valid for sixty months ☑ Authorization to Construct is valid for a period equal to that of Improvement Permit – not to exceed sixty months.

Signed: Darrell Abee date 3/18/08 Installed by: TIM ABEE

Improvement Permit by: STEVE HEDRICK date 3-18-08 Operation Permit by: STEVE HEDRICK date 4-24-08

Authorization to Construct by: STEVE HEDRICK date 3-18-08 Existing System Inspection by: date

HEALTH DEPT. COPY: WHITE OWNER COPY (FINAL): YELLOW OWNER COPY (INITIAL): PINK