IREDELL COUNTY HEALTH DEPARTMENT

STATESVILLE 704-878-5305 MOORESVILLE 704-664-5281

IMPROVEMENT PERMIT / AUTHORIZATION TO CONSTRUCT / OPERATION PERMIT / EXISTING SYSTEM INSPECTION

PERMIT# REPAIR PIN# DATE 11-13-98

OWNER OR CONTRACTOR REECE HENDERSON PHONE: Business Home 873-5079

ADDRESS 818 KENTWOOD DRIVE, STATESVILLE, NC 28677

LOCATION US 70 WEST, TR KENTWOOD DRIVE, 6TH LOT ON LEFT

SUBDIVISION KENTWOOD BLOCK / SECTION LOT LOT AREA LIMITED SITE CLASS. PS DESIGN FLOW 360 L.T.A.R. EXISTING

Septic Tank: EXISTING Gallons: STB Date

Pump Tank: Gallons: PT Date

Pump Make Model Serial No.

Nitrification Field: No Fields 1 Square Feet 270 Linear Feet 90

No Lines TWO Trench Width 36" Max Trench Bottom Depth 36" Gravel Depth (24")

☐ New System ✓ Repair System Type: I (II) III, IV, V, VI

System Description:

Repair System Description: CONVENTIONAL GRAVITY

Maintenance Agreement Required ☐ Yes ✓ No

☐ Slab ☐ Crawl Space ✓ Basement w/plumbing ☐ Basement wo/plumbing

✓ House/Mod. Home No. Bedrooms 3

☐ Mobile Home No. Bathrooms 2½

☐ Business No. Employees


☐ Other

Water Supply: ✓ Individual ☐ Public ☐ Community WELL

Comments/Conditions: ①USE 24 INCHES STONE DEPTH ②THIS PERMIT SERVES AS NOTICE OF VIOLATION SCALE: 1"=50'

Comments/Conditions:

INITIAL SITE SKETCH

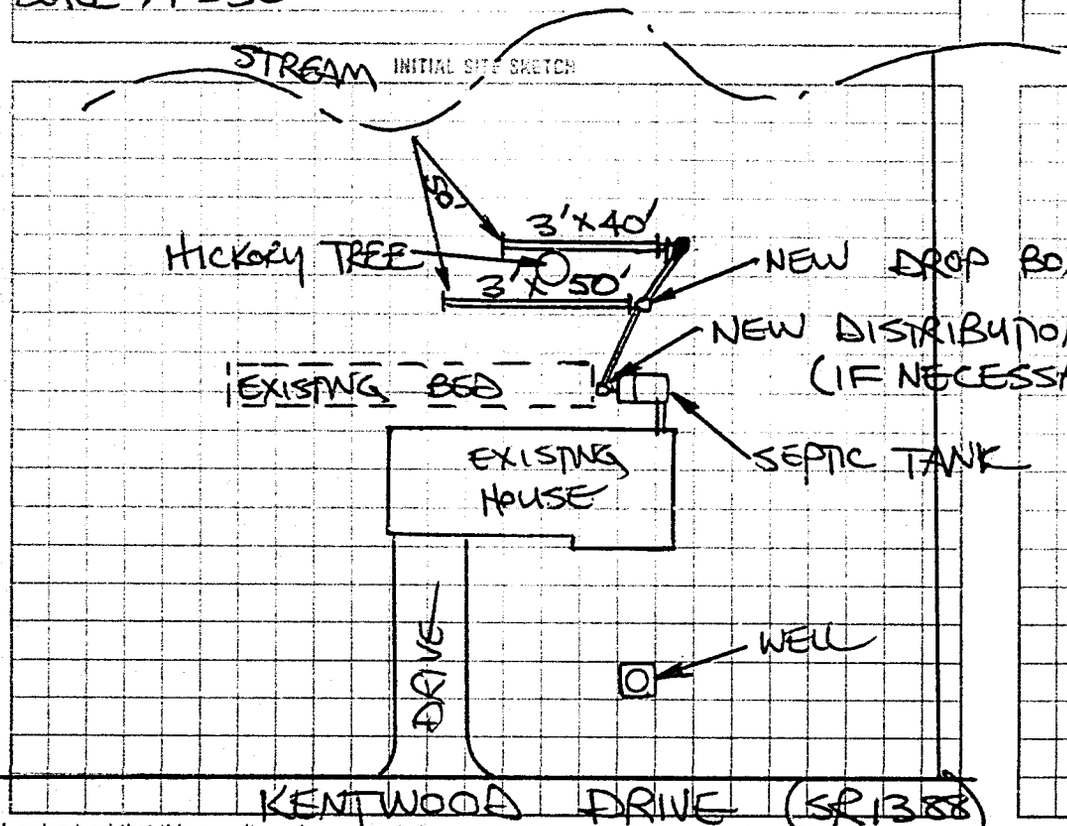

AS BUILT SKETCH

SYSTEM REPAIRED ACCORDING TO INITIAL SITE SKETCH

I understand that this permit can be suspended or revoked if any false information is supplied toward securing the permit/any unauthorized changes are made to the site/any unauthorized changes are made in the installation of the system. Improvement Permit with plat valid without expiration. Improvement Permit with site plan valid for sixty months. Authorization to Construct is valid for a period equal to that of Improvement Permit – not to exceed sixty months.

Signed: + Reece J. Henderson date 11-13-98

Improvement Permit by: STEVE HEDRICK date 11-13-98

Authorization to Construct by: STEVE HEDRICK date 11-13-98

Installed by: WESLEY LYTON

Operation Permit by: STEVE HEDRICK date 11-24-98

Existing System Inspection by: date

HEALTH DEPT. COPY: WHITE INSPECTION COPY (FINAL): GREEN OWNER COPY (FINAL): YELLOW INSPECTION COPY (INITIAL): PINK OWNER COPY (INITIAL): GOLD

67800