IREDELL COUNTY HEALTH DEPARTMENT

Statesville Office (704) 878-5305 Mooresville Office (704) 660-3625 PERMIT # 22/866

IMPROVEMENT PERMIT / AUTHORIZATION TO CONSTRUCT / OPERATION PERMIT / EXISTING SYSTEM

PIN # 4724449082

APPLICANT: Joanne B Samuels APPLICANT ADDRESS: 811 Kentwood Dr Statesville NC 28677

SITE ADDRESS: 811 Kentwood Dr Statesville NC 28677 PHONE: 704-880-7158 ALT. PHONE: 980-223-8979

SITE DIRECTIONS: 70 W past Bristol Dr TR Kentwood Dr Lot on right

SUBDIVISION: Kentwood Park SECTION: N/A LOT # 91-94 LOT AREA: 0.35ac DESIGN FLOW: Ex L.T.A.R.: Ex

Septic Tank 1000 (gal) STB 2071 Date
Pump Tank (gal) PT Date
Pump Make Model Serial #
Nitrification Fields Ex # Lines Ex Linear Ft: Ex
Trench Width Ex Max. Trench Bottom Depth Ex Gravel Depth Ex

☐ New System ☒ Repair ☐ Expansion System Type: I II III IV V VI
System Description: Tank
Repair System Description:
Maintenance Agreement Required: ☐ YES ☒ NO
☒ GRAVITY ☐ PRESSURE


☒ Residence No. Bedrooms Ex
☐ Business No. Persons
☐ Other No. Employees
☐ Slab ☒ Crawl Space
☐ Basement w/plumbing ☐ Basement w/o plumbing

Water Supply: ☒ Private ☐ Public ☐ Community

Comments / Conditions: Pump, crush + fill existing tank

TUFF TITE FILTER

INITIAL SITE SKETCH

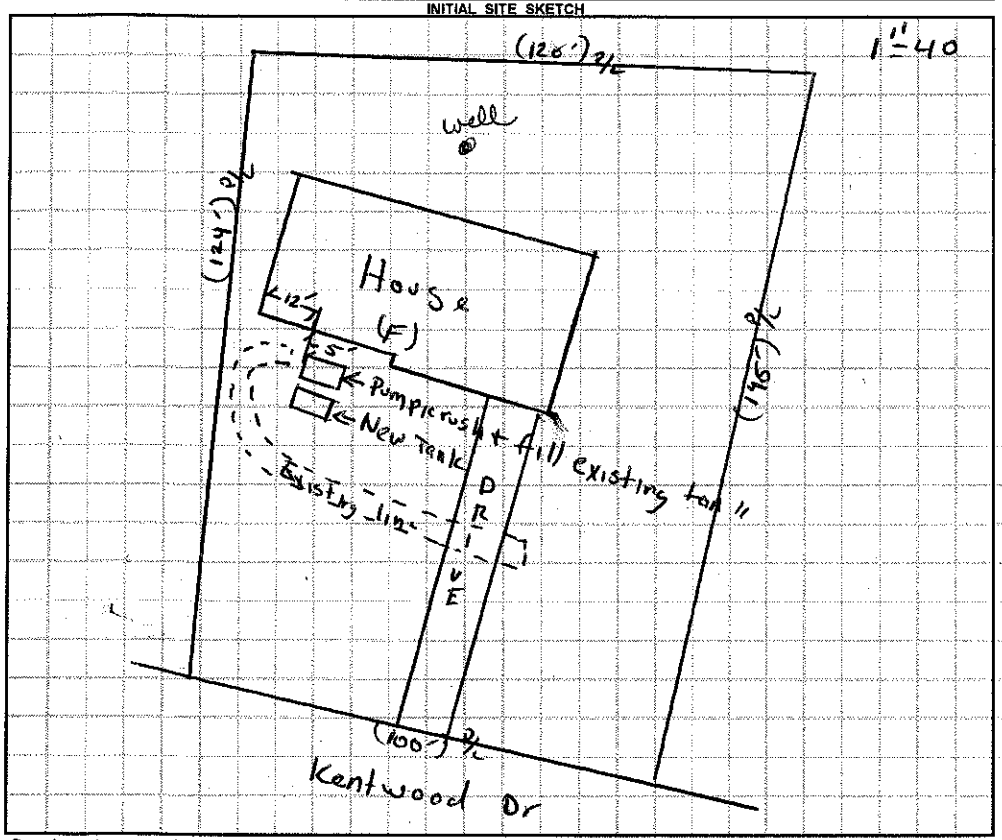

AS BUILT SKETCH

Permit can be suspended or revoked if any false information is supplied toward securing the permit / any unauthorized changes are made to the site / any unauthorized changes are made in the installation of the system. **CONTACT A LOCATOR SERVICE PRIOR TO ANY EXCAVATION**

☐ **IMPROVEMENT PERMIT** *with plat valid without expiration.* ☒ **IMPROVEMENT PERMIT** *with site plan valid for 60 mos.* ☒ **AUTHORIZATION TO CONSTRUCT** *valid for period equal to IMPROVEMENT PERMIT--not to exceed 60 mo.*

Owner / Applicant Signature: Date: 9-20-2016 Installed by:

IMPROVEMENT PERMIT by: Date: 09/23/16 OPERATION PERMIT by: Date: 9/28/16

AUTHORIZATION TO CONSTRUCT by: Date: 09/23/16 Existing System Inspected by: Date:

Health Dept. Copy - WHITE Applicant (Final Approval) - YELLOW Applicant (Conditional Approval) - PINK