IREDELL COUNTY HEALTH DEPARTMENT

Statesville Phone TR 3-7271 Mooresville Phone NO 3-1271

PERMIT TO INSTALL SEPTIC TANK

Permit NO. _____ Permit Date Sept 18 1968

Owner Sherrill Lumber Co. Address Old Bog Pass

Installed By _____ Address _____


Location of Property R. off Hickory Hwy. 3rd brick on R.

Tank		Capacity		Length of Lines		Fixtures	
Block	( )	800	( )	150'	( )	No. of Baths	(2)
Precast	(+)	900	( )	175'	( )	Dishwasher	( )
		1000	(+)	200'	( )	Garbage Grdr.	( )
		1100	( )	225'	(+)	Auto-Washer	(+)
		1200	( )	250'	( )	Other	_____
		Other	_____	Other	_____		

NOTIFY HEALTH DEPARTMENT AT LEAST EIGHT HOURS BEFORE TANK IS TO BE INSPECTED.

Final Inspection 9-18 1968 Approved (+) ~~Disapproved~~ ( )

Remarks well 50'

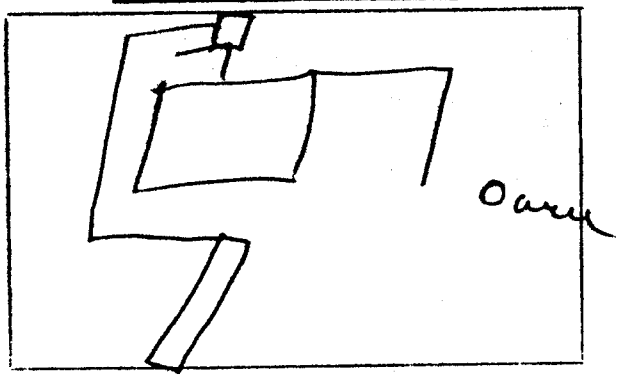

Sketch of Installation

Sanitarian