IREDELL COUNTY HEALTH DEPARTMENT

Statesville Phone TR 3-7271 Mooresville Phone NO 3-1271

PERMIT TO INSTALL SEPTIC TANK

Permit NO. _____ Permit Date Nov 4 1960

Owner Wesley East Piedmont Plb. Address old bypass

Installed By C Hicks Address R 7 -


Location of Property old bypass & Hickory Hwy 4th house on right -

Tank		Capacity		Length of Lines		Fixtures	
Block	( )	800	( )	150'	( )	No. of Baths	(2)
Precast	(1)	900	( )	175'	( )	Dishwasher	( )
		1000	(1)	200'	( )	Garbage Grdr.	( )
Cash		1100	( )	225'	(1)	Auto-Washer	(1)
		1200	( )	250'	( )	Other	
		Other		Other			

NOTIFY HEALTH DEPARTMENT AT LEAST EIGHT HOURS BEFORE TANK IS TO BE INSPECTED.

Final Inspection Nov 4 1960 Approved (✓) Disapproved ( )

Remarks No water on prop. will use neighbor well -

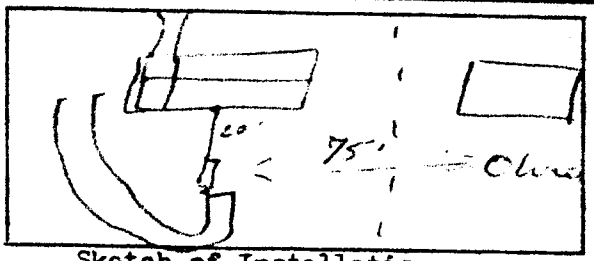

Sketch of Installation

RT

Sanitarian