IREDELL COUNTY HEALTH DEPARTMENT

STATESVILLE 704-878-5305 MOORESVILLE 704-664-5281

IMPROVEMENT PERMIT / AUTHORIZATION TO CONSTRUCT / OPERATION PERMIT / EXISTING SYSTEM INSPECTION

PERMIT# REPAIR PIN# 4724-45-1966 DATE 2-27-08

OWNER OR APPLICANT ROY F. & VICKIE C. KRESS PHONE: Business 704-872-3883 Home 704-872-5635

ADDRESS 627 WESTMINSTER DRIVE STATESVILLE, NC 28677

LOCATION US 70 WEST, TR WESTMINSTER DRIVE, ~1.0 MILE ON RIGHT AT BOX #627

SUBDIVISION _____ BLOCK / SECTION _____ LOT _____ LOT AREA 0.57 ACRE SITE CLASS. PS DESIGN FLOW 240 L.T.A.R. 0.30 GPD/FT2

Septic Tank EXISTING Gallons: STB _____ Date _____

Pump Tank: _____ Gallons: PT _____ Date _____

Pump Make: _____ Model _____ Serial No. _____

Nitrification Field: No Fields 1 Square Feet EQ.FT 800 Linear Feet 200

No Lines THREE Trench Width 36" Max Trench Bottom Depth 48" +/- Gravel Depth N/A

☐ New System ☑ Repair ☐ Expansion System Type: I II III IV V VI

System Description: _____

Repair System Description: 25% REDUCTION, GRAVITY

Maintenance Agreement Required: ☐ Yes ☒ No

☑ Gravity ☐ Pressure ☐ Slab ☐ Crawl Space ☐ Basement w/plumbing ☑ Basement wo/plumbing

☑ House/Mod. Home No. Bedrooms 2

☐ Mobile Home No. Persons ____

☐ Business No. Employees ____


☐ Other _____

Water Supply: ☑ Individual ☐ Public ☐ Community WELL

Comments/Conditions: ① INSTALL NEW SANITARY TEE IN SEPTIC TANK IF NECESSARY ② INSTALL NEW DISTRIBUTION BOX AT LOCATION SHOWN FEEDING NEW DRAINFIELD FIRST, OLD DRAINFIELD 2ND ③ USE 25% REDUCTION

Comments/Conditions:

INITIAL SITE SKETCH

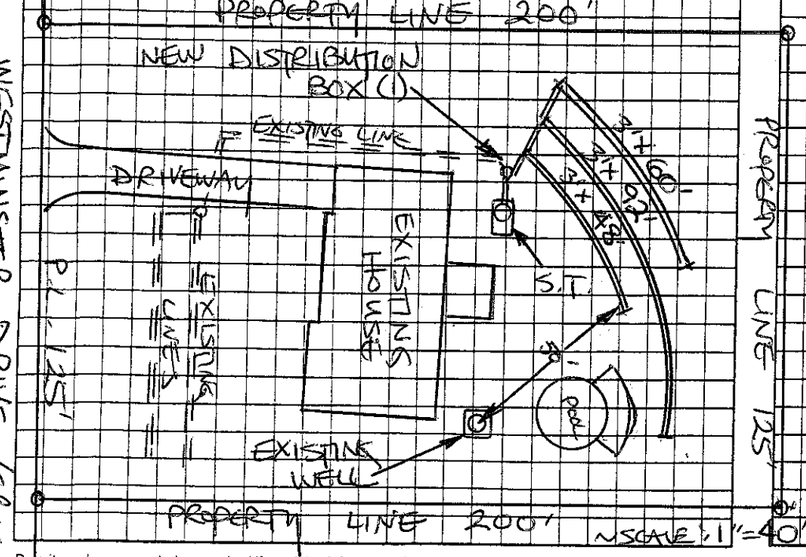

AS BUILT SKETCH

Installed As Drawn

Permit can be suspended or revoked if any false information is supplied toward securing the permit/any unauthorized changes are made to the site/any unauthorized changes are made in the installation of the system. Improvement Permit with plat valid without expiration ☐ Improvement Permit with site plan valid for sixty months ☒ Authorization to Construct is valid for a period equal to that of Improvement Permit – not to exceed sixty months.

Signed: X Roy F Kress date 2/27/2008

Improvement Permit by: STEVE HEDRICK date 2-27-08

Authorization to Construct by: STEVE HEDRICK date 2-27-08

Installed by: Wayne Clontz

Operation Permit by: _____, R.S. date 27 MARCH 08

Existing System Inspection by: _____ date _____

HEALTH DEPT. COPY: WHITE OWNER COPY (FINAL): YELLOW OWNER COPY (INITIAL): PINK