IREDELL COUNTY HEALTH DEPARTMENT

ROSA HEVAO

STATESVILLE 704-878-5305 MOORESVILLE 704-664-5281

IMPROVEMENT PERMIT / AUTHORIZATION TO CONSTRUCT / OPERATION PERMIT / EXISTING SYSTEM INSPECTION

PERMIT# REPAIR PIN# 4724-45-3320 DATE 2-2-05

OWNER OR CONTRACTOR JULIO MORENO PHONE: Business Home 704-871-8935

ADDRESS 727 WESTMINSTER DRIVE STATESVILLE NC 28677

LOCATION US 70 WEST, TR WESTMINSTER DRIVE, HOUSE ON RIGHT AT BOX #727

SUBDIVISION BLOCK / SECTION LOT LOT AREA 3.22 ACRES SITE CLASS. PS DESIGN FLOW 480 L.T.A.R. 0.30 GPD/FT²

Septic Tank: EXISTING Gallons; STB Date

Pump Tank: Gallons; PT Date

Pump Make: Model Serial No.

Nitrification Field: No Fields 1 Square Feet 900 Linear Feet 300

No Lines TWO Trench Width 36" Max Trench Bottom Depth 36" +/- Gravel Depth 18"

☐ New System ☑ Repair System Type: I, II, III, IV, V, VI

System Description:

Repair System Description: CONVENTIONAL, GRAVITY

Maintenance Agreement Required: ☐ Yes ☑ No

☑ House/Mod. Home No. Bedrooms 4

☐ Mobile Home No. Bathrooms

☐ Business No. Employees

☐ Other


☐ Slab ☑ Crawl Space ☐ Basement w/plumbing ☐ Basement wo/plumbing

Water Supply: ☑ Individual ☐ Public ☐ Community WELL

Comments:/Conditions: USE NEW 4" x 45' SUPPLY LINE FROM SEPTIC TANK TO NEW DROP BOX FEEDING TWO NEW 3' x 150' DRAINLINES USING 18" STONE ON CONTOUR AS FLAGGED

Comments:/Conditions:

INITIAL SITE SKETCH

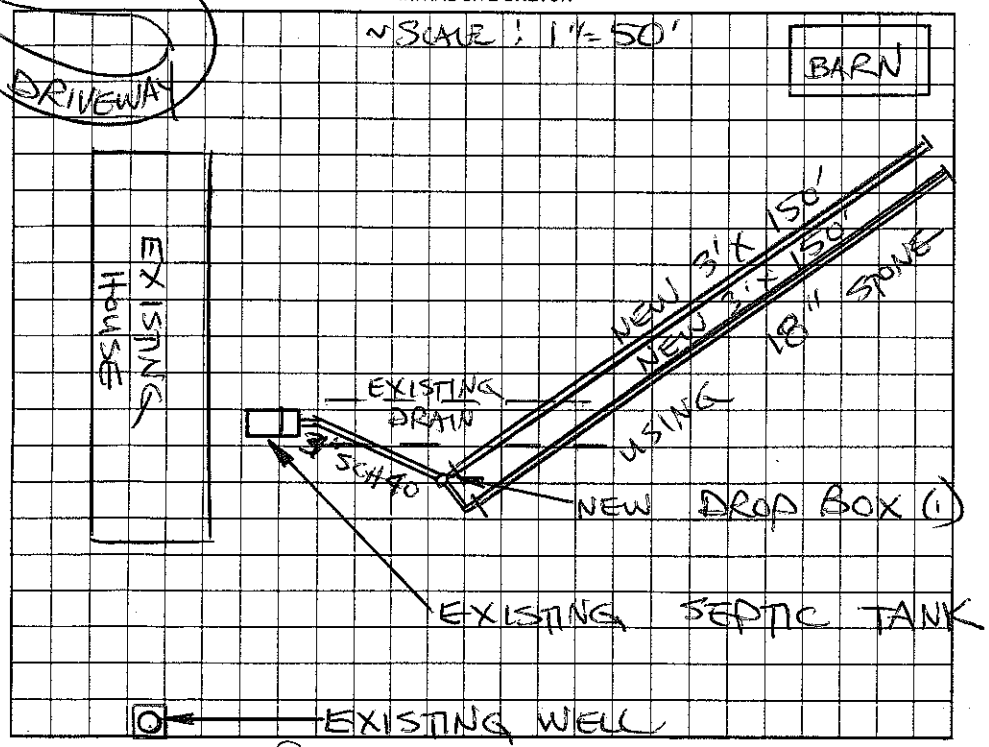

AS BUILT SKETCH

SYSTEM REPAIRED ACCORDING TO INITIAL SITE SKETCH

Permit can be suspended or revoked if any false information is supplied toward securing the permit/any unauthorized changes are made to the site/any unauthorized changes are made in the installation of the system. Improvement Permit with plat valid without expiration. Improvement Permit with site plan valid for sixty months. Authorization to Construct is valid for a period equal to that of Improvement Permit – not to exceed sixty months.

Signed: [signature] date 2-2-05 Installed by: IREDELL BACKHOE

Improvement Permit by: STEVE HEDRICK date 2-2-05 Operation Permit by: STEVE HEDRICK date 2-8-05

Authorization to Construct by: STEVE HEDRICK date 2-2-05 Existing System Inspection by: date

HEALTH DEPT. COPY: WHITE OWNER COPY (FINAL): YELLOW OWNER COPY (INITIAL): PINK