*PERMIT REPLACES PREVIOUS ISSUE 3-21-05 #124992, NOW VOID

# IREDELL COUNTY HEALTH DEPARTMENT

STATESVILLE 704-878-5305 MOORESVILLE 704-664-5281

## IMPROVEMENT PERMIT / AUTHORIZATION TO CONSTRUCT / OPERATION PERMIT / EXISTING SYSTEM INSPECTION

PERMIT# 124992 PIN# 4724-46-7320 DATE 6-2-05

OWNER OR CONTRACTOR GLORYLAND BAPTIST CHURCH PHONE: Business 704-592-4411 Home

ADDRESS 915 OLD MOUNTAIN RD. STATESVILLE NC 28677

LOCATION TAKE W. FRONT ST TO BRISTOL DR. @ WESTMINSTER DR. ~0.9 MILES ON LEFT

SUBDIVISION C BLOCK / SECTION LOT LOT AREA 6.857 SITE CLASS. PS DESIGN FLOW 528 L.T.A.R. 0.30 GPD/FT²

Septic Tank: 1000 Gallons; STB 794 Date 7-16-05 ☑ New System ☐ Repair System Type: I, II, (III) IV, V, VI

Pump Tank: 1000 Gallons; PT 283 Date 11-23-05 System Description: PUMP CONVENTIONAL

Pump Make: GOULDS Model WE0311M Serial No. G0573244 Repair System Description: SAME

Nitrification Field: No Fields 1 Square Feet 1760 Linear Feet ~~590~~ 440 Maintenance Agreement Required: ☐ Yes ☑ No

No Lines FIVE (5) Trench Width 36" Max Trench Bottom Depth 36" Gravel Depth 12"

☑ Slab ☐ Crawl Space ☐ Basement w/plumbing ☐ Basement wo/plumbing

☐ House/Mod. Home No. Bedrooms

☐ Mobile Home No. Bathrooms

☐ Business No. Employees


☑ Other 40x96' CHURCH W/176 MEMBERS

Water Supply: ☑ Individual ☐ Public ☐ Community


Comments/Conditions: ① MAINTAIN SETBACKS (100' FROM WELL) (15' FROM >2' EMBANKMENT) (5' FROM SLAB FOUNDATION) ② INSTALL SYSTEM ON CONTOUR ③ THIS SYSTEM IS SIZED FOR A CHURCH W/O A KITCHEN.

Comments/Conditions: ① SEPTIC TANK WITH MARKER INSTALLED USING RED "PolyLOK" FILTER ② AN ACCEPTED SYSTEM WAS INSTALLED USING 110 "QUICK-4" INFILTRATOR CHAMBERS

INITIAL SITE SKETCH

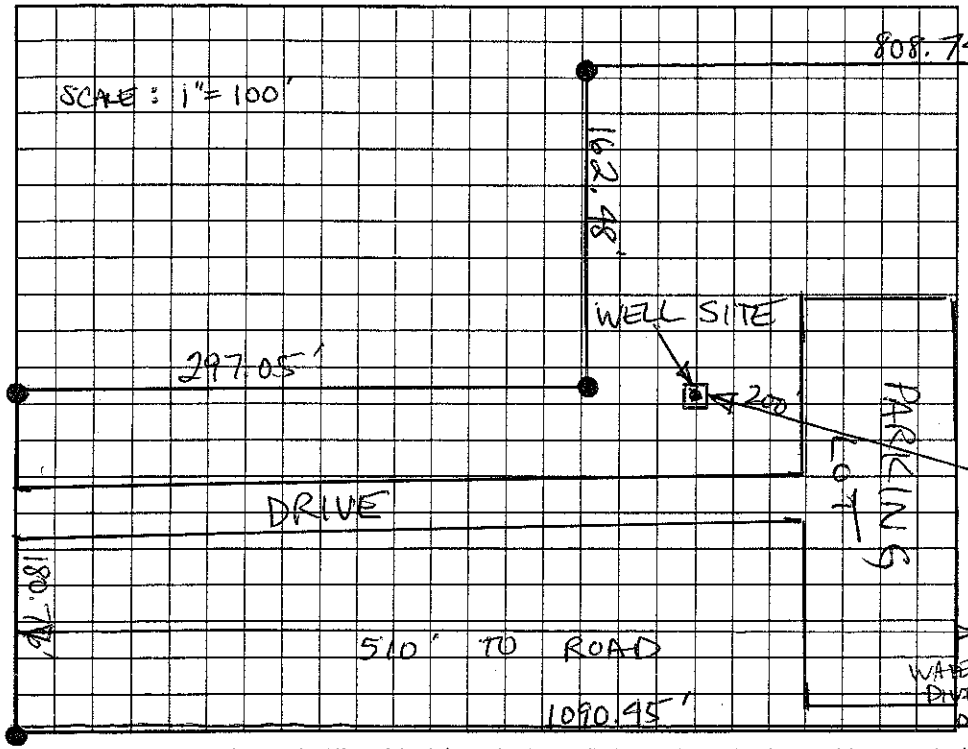


AS BUILT SKETCH

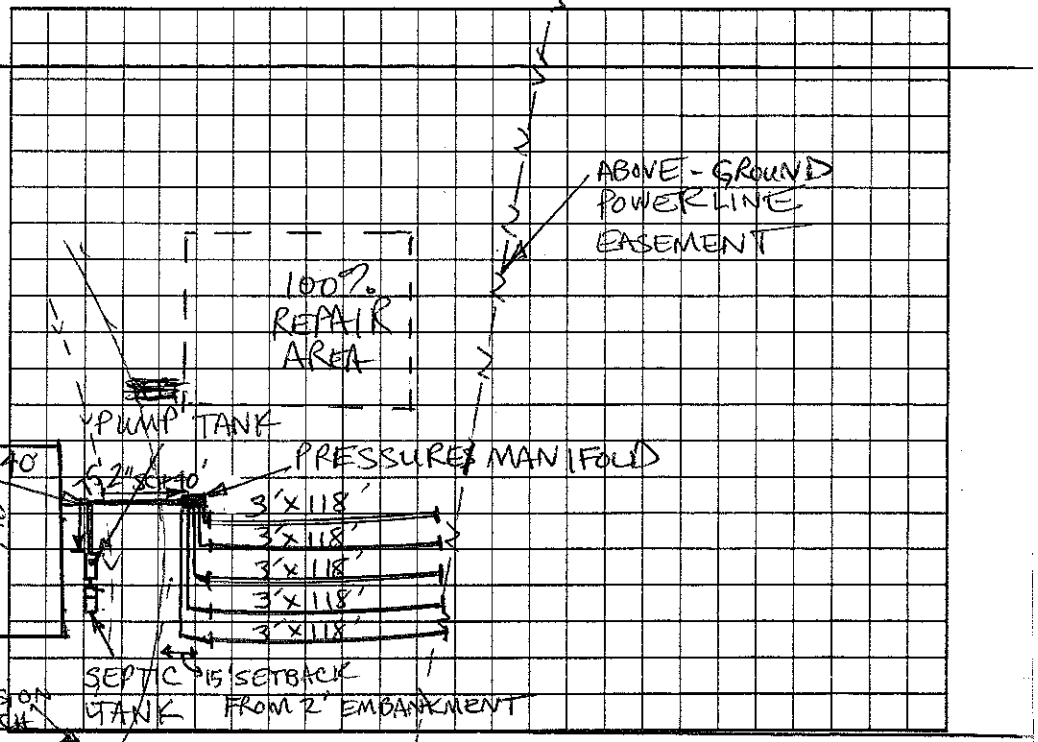


Permit can be suspended or revoked if any false information is supplied toward securing the permit/any unauthorized changes are made to the site/any unauthorized changes are made in the installation of the system. Improvement Permit with plat valid without expiration. Improvement Permit with site plan valid for sixty months. Authorization to Construct is valid for a period equal to that of Improvement Permit – not to exceed sixty months.

Signed: Randy H Wilcox date 6-2-05 Installed by: MARTY TUCKER, TUCKER'S HAULING & GRADING

Improvement Permit by: Christopher M. Sherrill, RS, LSS date 6-2-05 Operation Permit by: STEVE HEDRICK date 8-2-06

Authorization to Construct by: Christopher M. Sherrill, RS date 6-2-05 Existing System Inspection by: date

HEALTH DEPT. COPY: WHITE OWNER COPY (FINAL): YELLOW OWNER COPY (INITIAL): PINK