IREDELL COUNTY HEALTH DEPARTMENT

Statesville Phone TR 3-7271 Mooresville Phone NO 3-1271

PERMIT TO INSTALL SEPTIC TANK

Permit NO._____ Permit Date January 31, 1958

Owner SAM BARKER Address Rt. 8, Statesville, N.C.

Installed By M. HARRIS Address Shelton Ave, Statesville


Location of Property Just behind Carolina Inn Restaurant on left - trailer.

Tank		Capacity		Length of Lines		Fixtures	
Block	( )	800	( )	150'	(✓)	No. of Baths	(1)
Precast	(X)	900	( )	175'	( )	Dishwasher	( )
		1000	(✓)	200'	( )	Garbage Grdr.	( )
		1100	( )	225'	( )	Auto-Washer	( )
		1200	( )	250'	( )	Other	
		Other		Other			

NOTIFY HEALTH DEPARTMENT AT LEAST EIGHT HOURS BEFORE TANK IS TO BE INSPECTED.

Final Inspection January 31st 1958 Approved (X) Disapproved ( )

Remarks No water on property - trailer - tuff lite.

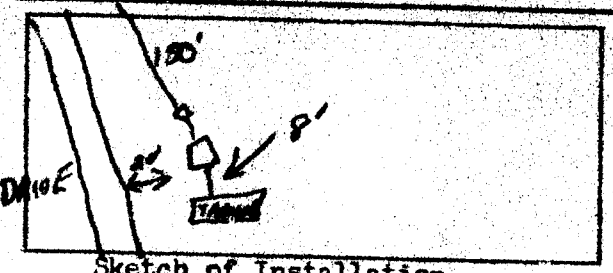

Sketch of Installation

Rayford A. Thomas

Sanitarian