IREDELL COUNTY HEALTH DEPARTMENT

STATESVILLE 704-878-5305 MOORESVILLE 704-664-5281

IMPROVEMENT PERMIT / AUTHORIZATION TO CONSTRUCT / OPERATION PERMIT / EXISTING SYSTEM INSPECTION

PERMIT # 158401 PIN # 4734-53-2479 DATE 22 MARCH 10

OWNER or APPLICANT Willard Lee Auton PHONE: Business Home: (704) 929-0543

OWNER or APPLICANT ADDRESS 273 Gilbert Rd. Statesville, N.C.

LOCATION / DIRECTIONS Hwy 70 W. Turn onto Reynolds Rd. - House on left.

SUBDIVISION Auton Property B/D BLOCK / SECTION LOT # 2 LOT AREA .5 Ac. DESIGN FLOW 240 g/d. L.T.A.R. 0.3 g/ft²/d

Septic Tank 1000 Gallons: STB 1007 Date 12-14-09

Pump Tank Gallons: P T Date

Pump Make Model Serial #

Nitrification Field No Fields 1 No Lines 3 Linear Feet 200

Trench Width 36" Max. Trench Bottom Depth 36" Gravel Depth N/A

☑ New System ☐ Repair ☐ Expansion System Type I II ◯III IV V VI

System Description: 25% Reduction

Repair System Description: 25% Reduction

Maintenance Agreement Required ☐ YES ☑ NO

☑ GRAVITY ☐ PRESSURE

☑ Residence No. Bedrooms 2

☐ Business No. Persons

☐ Other No. Employees

☐ Slab ☑ Crawl Space

☐ Basement w/plumbing ☐ Basement w/o plumbing

Water Supply: ☑ Private ☐ Public ☐ Community


Comments / Conditions * Keep 100' from well / follow contours

Reynolds Rd.

Comments / Conditions * House already set-up on site.

* Polylock filter tee

INITIAL SITE SKETCH

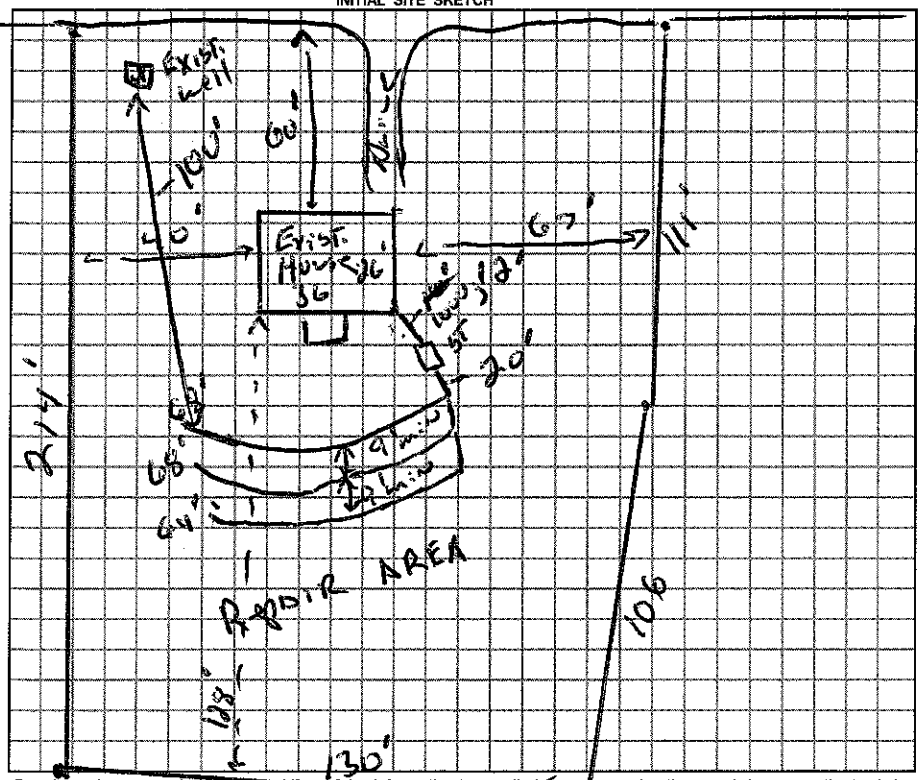

AS BUILT SKETCH

Installed as Drawn

Permit can be suspended or revoked if any false information is supplied toward securing the permit / any unauthorized changes are made to the site / any unauthorized changes are made in the installation of the system.

☐ *IMPROVEMENT PERMIT w / plat valid without expiration.* ☑ *IMPROVEMENT PERMIT w / site plan valid for 60 mos.* ☑ *AUTHORIZATION TO CONSTRUCT valid for period equal to IMPROVEMENT PERMIT-not to exceed 60 mo.*

Owner / Applicant Signature: James Hedden Date 3/23/10

Improvement Permit by: R.S. Date 22 March 10

Authorization to Construct by: R.S. Date 22 March 10

Installed by: James Hedden

Operation Permit by: R.S. Date: 25 March 10

Existing System Inspected by: Date:

YOU SHOULD CONTACT A LOCATOR SERVICE PRIOR TO ANY EXCAVATION.

WHITE COPY Environmental Health YELLOW COPY (Final) Owner / Applicant PINK COPY (Initial) Owner / Applicant