IREDELL COUNTY HEALTH DEPARTMENT

Statesville Phone TR 3-7271 Mooresville Phone NO 3-1271

PERMIT TO INSTALL SEPTIC TANK

Permit NO. _____ Permit Date June 5 - 1964

Owner Mr. Billie Carlton Address Statesville

Installed By Ray Trent Address Statesville


Location of Property Pumkin Rd. 5-th house on Right

| Tank | | Capacity | | Length of Lines | | Fixtures | |
|---|---|---|---|---|---|---|---|
| Block | ( ) | 800 | ( ) | 150' | ( ) | No. of Baths | (1) |
| Precast | ( ) | 900 | ( ) | 175' | ( ) | Dishwasher | ( ) |
| Concrete | | 1000 | (✓) | 200' | ( ) | Garbage Grdr. | ( ) |
| | | 1100 | ( ) | 225' | (✓) | Auto-Washer | (1) |
| | | 1200 | ( ) | 250' | ( ) | Other | |
| | | Other | | Other | | | |

NOTIFY HEALTH DEPARTMENT AT LEAST EIGHT HOURS BEFORE TANK IS TO BE INSPECTED.

Final Inspection 6-5 1964 Approved (✓) Disapproved ( )

Remarks Septic

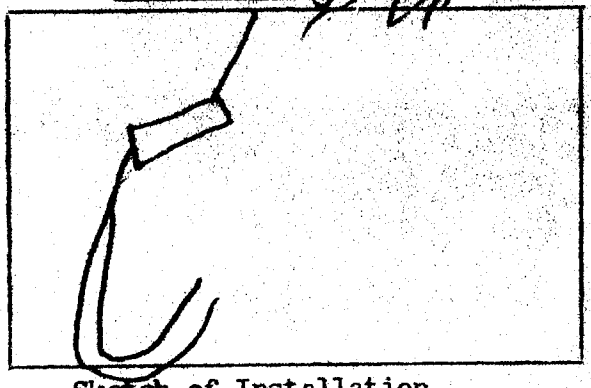

Sketch of Installation

R.L.

Sanitarian