IREDELL COUNTY HEALTH DEPARTMENT

Statesville Phone TR 3-7271 Mooresville Phone NO 3-1271

PERMIT TO INSTALL SEPTIC TANK

Permit Date _____ 19__

Permit NO. _____

Owner Mr. Harold Dellinger Address Statesville

Installed By Ray & Lentz Address Statesville


Location of Property Reynolds Rd Lucas Chapel Rd

Tank		Capacity		Length of Lines		Fixtures	
Block	(x)	800	( )	150'	( )	No. of Baths	(1)
Precast	( )	900	( )	175'	( )	Dishwasher	( )
		1000	(x)	200'	( )	Garbage Grdr.	( )
		1100	( )	225'	(x)	Auto-Washer	( )
		1200	( )	250'	( )	Other _____	
		Other _____		Other _____			

NOTIFY HEALTH DEPARTMENT AT LEAST EIGHT HOURS BEFORE TANK IS TO BE INSPECTED.

Final Inspection _____ 19__ Approved ( ) Disapproved ( )

Remarks _____

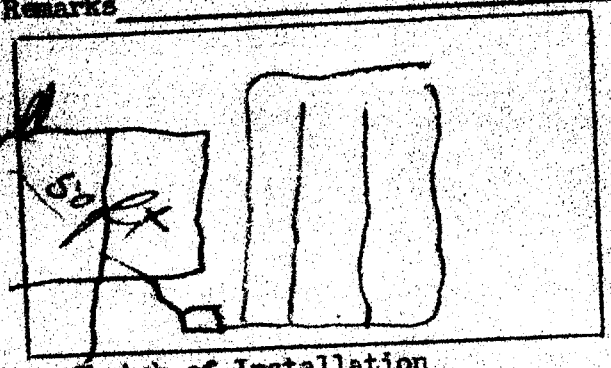

Sketch of Installation

_____ Sanitarian