IREDELL COUNTY HEALTH DEPARTMENT - *ENVIRONMENTAL HEALTH* ☒ STATESVILLE OFFICE 704-878-5305 ☐ MOORESVILLE OFFICE 704-664-5281

IMPROVEMENT PERMIT / AUTHORIZATION TO CONSTRUCT / OPERATION PERMIT / EXISTING SYSTEM INSPECTION @

PERMIT # 164119 PIN # 4724-53-5378 DATE 1-12-10

OWNER Douglas Dellinger APPLICANT: Same PHONE: Home/Cell # 7048726016 Business # 7049020497

SITE ADDRESS 2826 J Newton Dr. OWNER / APPLICANT ADDRESS

SITE DIRECTIONS Newton Drive West - 3rd House on (R) past Bristol

SUBDIVISION n/a BLOCK / SECTION n/a LOT # n/a LOT AREA .37 DESIGN FLOW 360 L.T.A.R. Ex

Septic Tank Ex Gallons: STB Date

Pump Tank Gallons: P T Date

Pump Make Model Serial #

No. Nitrification Fields: Ex No. Lines Ex Linear Feet Ex

Trench Width Ex Max. Trench Bottom Depth Ex Gravel Depth Ex

☐ New System ☐ Repair ☐ Expansion System Type I (II) III IV V VI

System Description: Existing

Repair System Description:

Maintenance Agreement Required ☐ YES ☒ NO

☒ GRAVITY ☐ PRESSURE

☒ Residence No. Bedrooms 3

☐ Business No. Persons

☐ Other No. Employees

☐ Slab ☒ Crawl Space

☐ Basement w/plumbing ☐ Basement w/o plumbing

Water Supply

☐ Private


☒ Public

☐ Community

Comments / Conditions

INITIAL SITE SKETCH

AS BUILT SKETCH

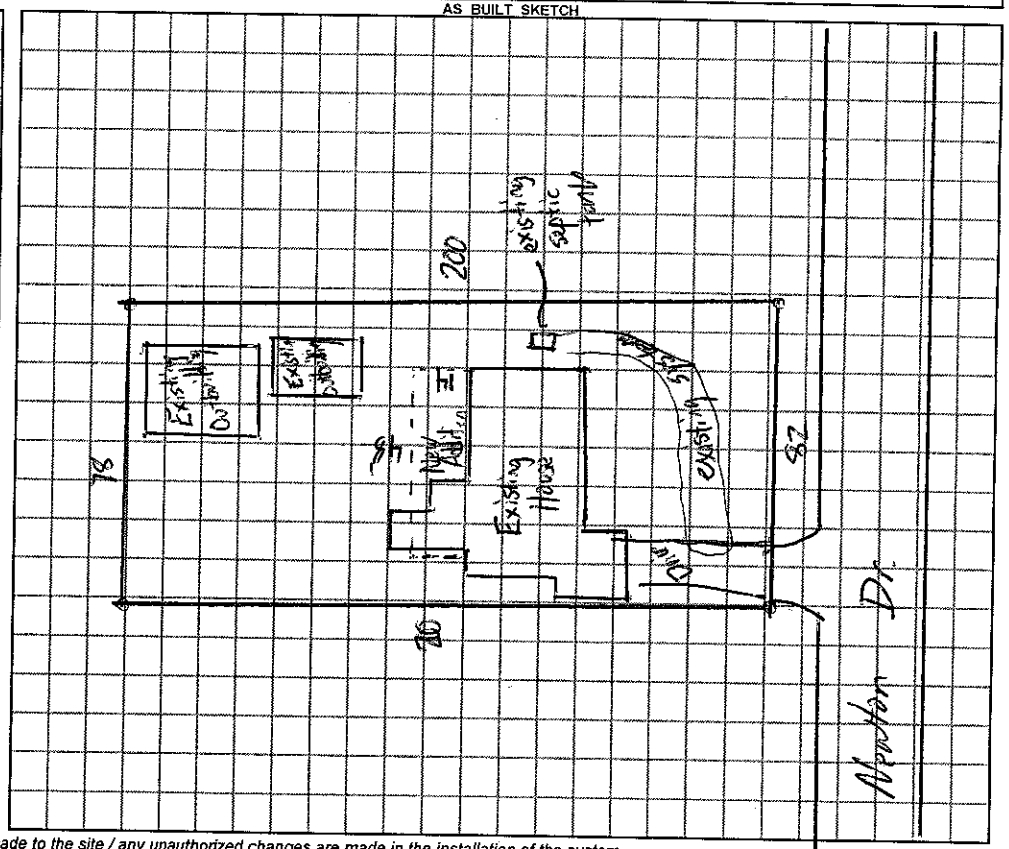

Permit can be suspended or revoked if any false information is supplied toward securing the permit / any unauthorized changes are made to the site / any unauthorized changes are made in the installation of the system.

☐ ***IMPROVEMENT PERMIT*** *with plat valid without expiration.* ☐ ***IMPROVEMENT PERMIT*** *with plat valid without expiration.* ☐ ***AUTHORIZATION TO CONSTRUCT*** valid for period equal to IMPROVEMENT PERMIT--not to exceed 60 mo.

Owner / Applicant Signature: Douglas A. Dellinger Date 1/12/11 Installed by:

IMPROVEMENT PERMIT by: REHS Date OPERATION PERMIT by: REHS Date

AUTHORIZATION TO CONSTRUCT by: REHS Date Existing System Inspected by: REHS Date 1-12-10

YOU SHOULD CONTACT A LOCATOR SERVICE PRIOR TO ANY EXCAVATION

White Copy – Environmental Health YELLOW COPY (Final) Owner / Applicant PINK COPY (Initial) Owner / Applicant