THIS PERMIT REPLACES PREVIOUS ISSUED 6-15-2009

IREDELL COUNTY HEALTH DEPARTMENT

STATESVILLE 704-878-5305 (a) (a) MOORESVILLE 704-664-5281

IMPROVEMENT PERMIT / AUTHORIZATION TO CONSTRUCT / OPERATION PERMIT / EXISTING SYSTEM INSPECTION

PERMIT # 156994 PIN # 4724-53-6131 DATE JANUARY 9 2009

OWNER or APPLICANT BOB STAMEY PHONE: Business 704-872-9445 Home: 704-872-7706

OWNER or APPLICANT ADDRESS 2835 NEWTON DRIVE, STATESVILLE, NC 28677

LOCATION / DIRECTIONS US 70 WEST, HOUSE ON LEFT AT Box # 2835

SUBDIVISION — BLOCK / SECTION — LOT # — LOT AREA 1.47 DESIGN FLOW 600 L.T.A.R. 0.30 GPD/FT2

Septic Tank 1500 Gallons: STB 268 Date 3-3-09
Pump Tank — Gallons: PT — Date —
Pump Make — Model — Serial # —
Nitrification Field No Fields 1 No Lines 5 Linear Feet 500 667'
Trench Width 36" Max. Trench Bottom Depth 36" Gravel Depth 12"

☑ New System ☐ Repair ☐ Expansion System Type I II III IV V VI
System Description: 25% REDUCTION CONVENTIONAL GRAVITY
Repair System Description: CONVENTIONAL GRAVITY
Maintenance Agreement Required ☐ YES ☑ NO
☑ GRAVITY ☐ PRESSURE


☑ Residence No. Bedrooms 5
☐ Business No. Persons —
☐ Other No. Employees —
☐ Slab ☑ Crawl Space
☐ Basement w/plumbing ☐ Basement w/o plumbing

Water Supply: ☑ Private ☐ Public ☐ Community


Comments / Conditions ① SEE ATTACHED EASEMENT FOR P/L CROSSING.
② AN "ACCEPTED SYSTEM" MAY ALSO BE USED.

Comments / Conditions SEPTIC TANK W/ RISERS & MARKER INSTALLED USING RED "POLYLOK" FILTER

INITIAL SITE SKETCH

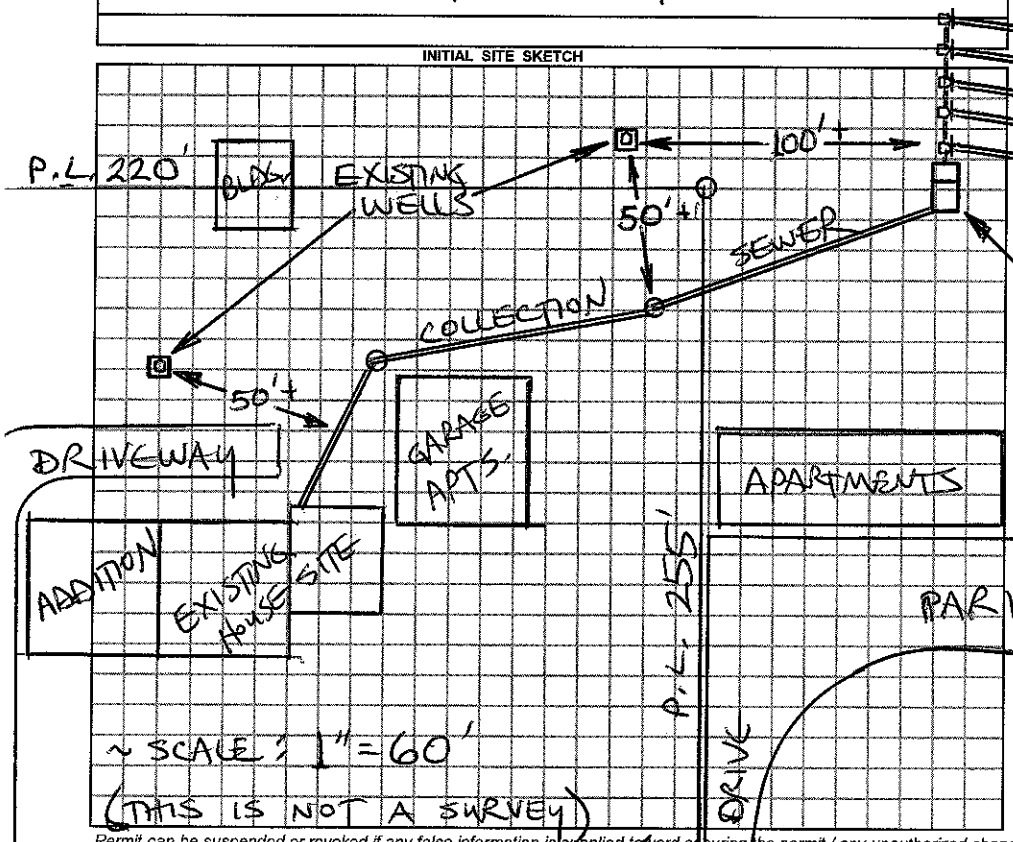

AS BUILT SKETCH

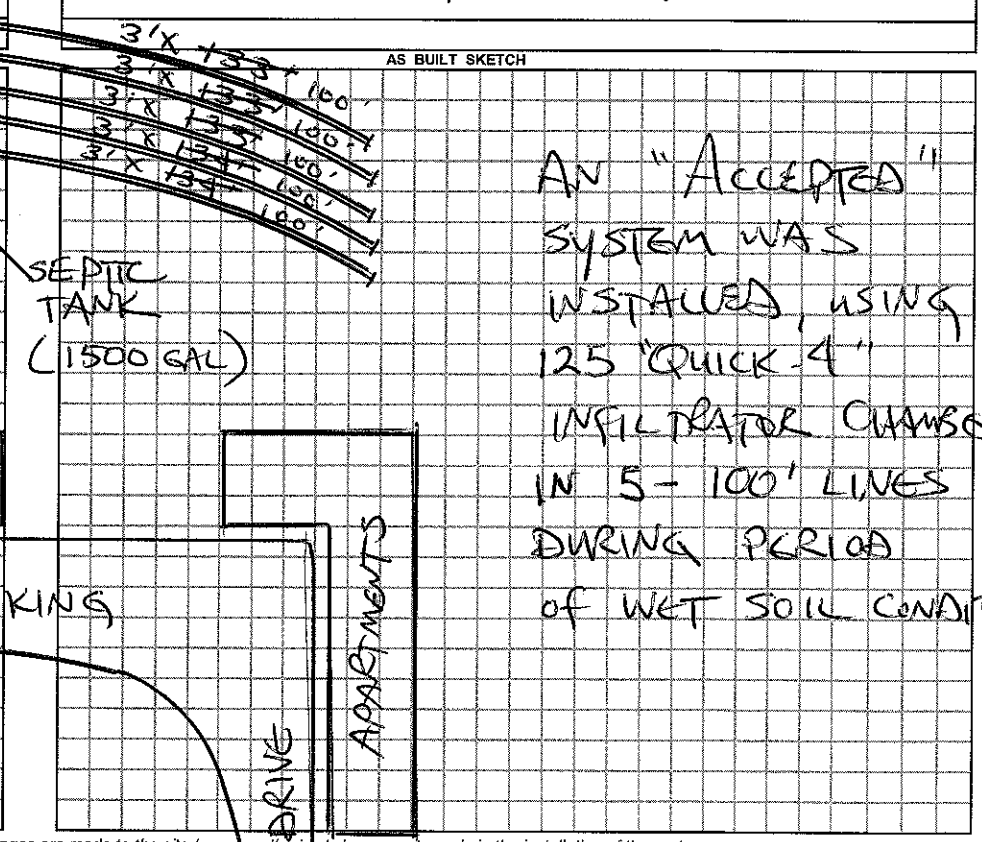

Permit can be suspended or revoked if any false information is supplied toward securing the permit / any unauthorized changes are made to the site / any unauthorized changes are made in the installation of the system.

☐ *IMPROVEMENT PERMIT w / plat valid without expiration.* ☑ *IMPROVEMENT PERMIT w / site plan valid for 60 mos.* ☐ *AUTHORIZATION TO CONSTRUCT valid for period equal to IMPROVEMENT PERMIT-not to exceed 60 mo.*

Owner / Applicant Signature: Jun Stamey Date 12-9-09

Improvement Permit by: STEVE HEDRICK Date 12-9-09

Authorzation to Construct by: STEVE HEDRICK Date 12-9-09

Installed by: KELLY WELLBORNE

Operation Permit by: STEVE HEDRICK Date: 12-11-09

Existing System Inspected by: — Date: —

YOU SHOULD CONTACT A LOCATOR SERVICE PRIOR TO ANY EXCAVATION.

WHITE COPY Environmental Health YELLOW COPY (Final) Owner / Applicant PINK COPY (Initial) Owner / Applicant

NEWTON DRIVE (US 70 WEST)