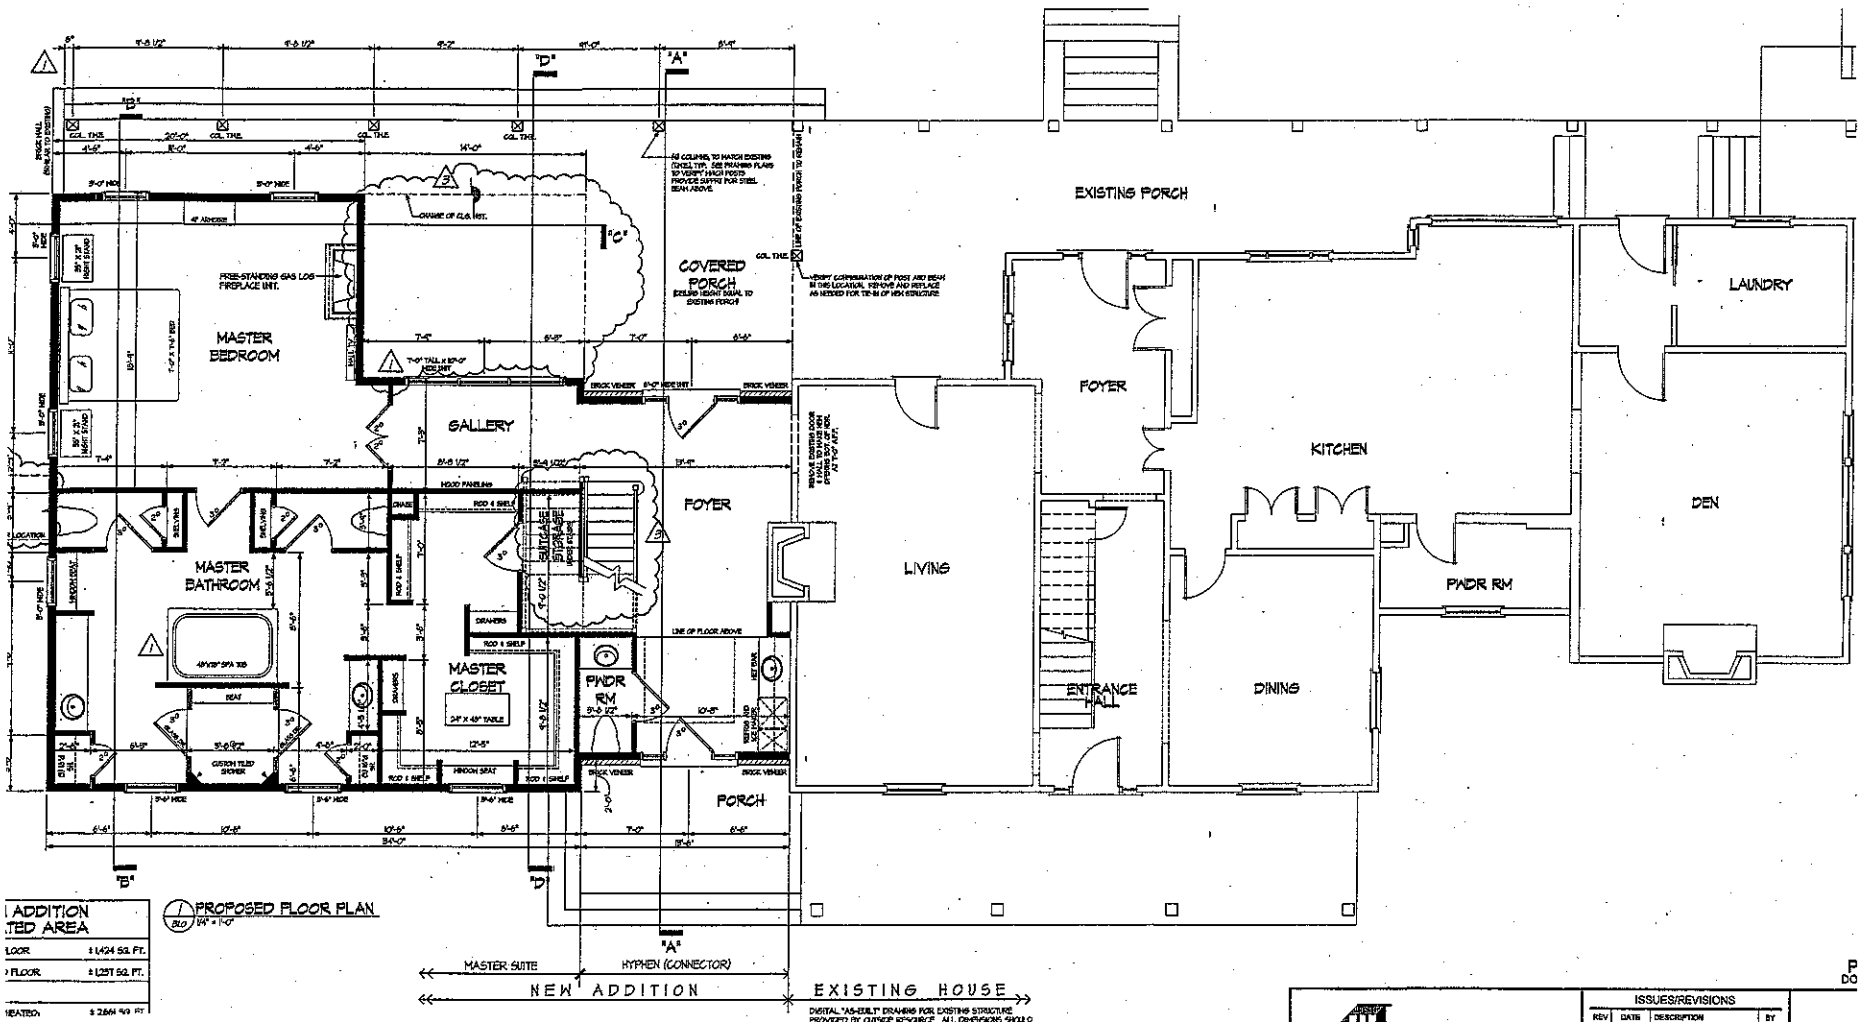


ADDITION
TED AREA

LOOR	± 1,424 SQ. FT.
FLOOR	± 1,257 SQ. FT.
HEATED	± 2,681 SQ. FT.

1/BLD PROPOSED FLOOR PLAN
1/4" = 1'-0"


DIGITAL "AS-BUILT" DRAWING FOR EXISTING STRUCTURE PROVIDED BY OUTSIDE RESOURCE. ALL DIMENSIONS SHOULD BE VERIFIED FOR ACCURACY BEFORE CONSTRUCTION BEGINS. ANY DISCREPANCIES SHOULD BE BROUGHT TO THE ATTENTION OF THE DESIGNER FOR REMEDIATION.

G.L. WILSON BUILDING COMPANY
180 WILSON FARM ROAD | STATESVILLE, NC 28625-8508
PHONE 704.873.2691 FAX 704.873.2691

ISSUES/REVISIONS

REV	DATE	DESCRIPTION	BY
1	8-5-09	PORCH, MASTER BATH, GALLERY	DRS
2	11-20-09	SECUR LOC., STAIR, PORCH	DRS

Acknowledgement Of
Plans Submittal ONLY!
Steve Hedrick Date 9/30/09
Date 12/9/09

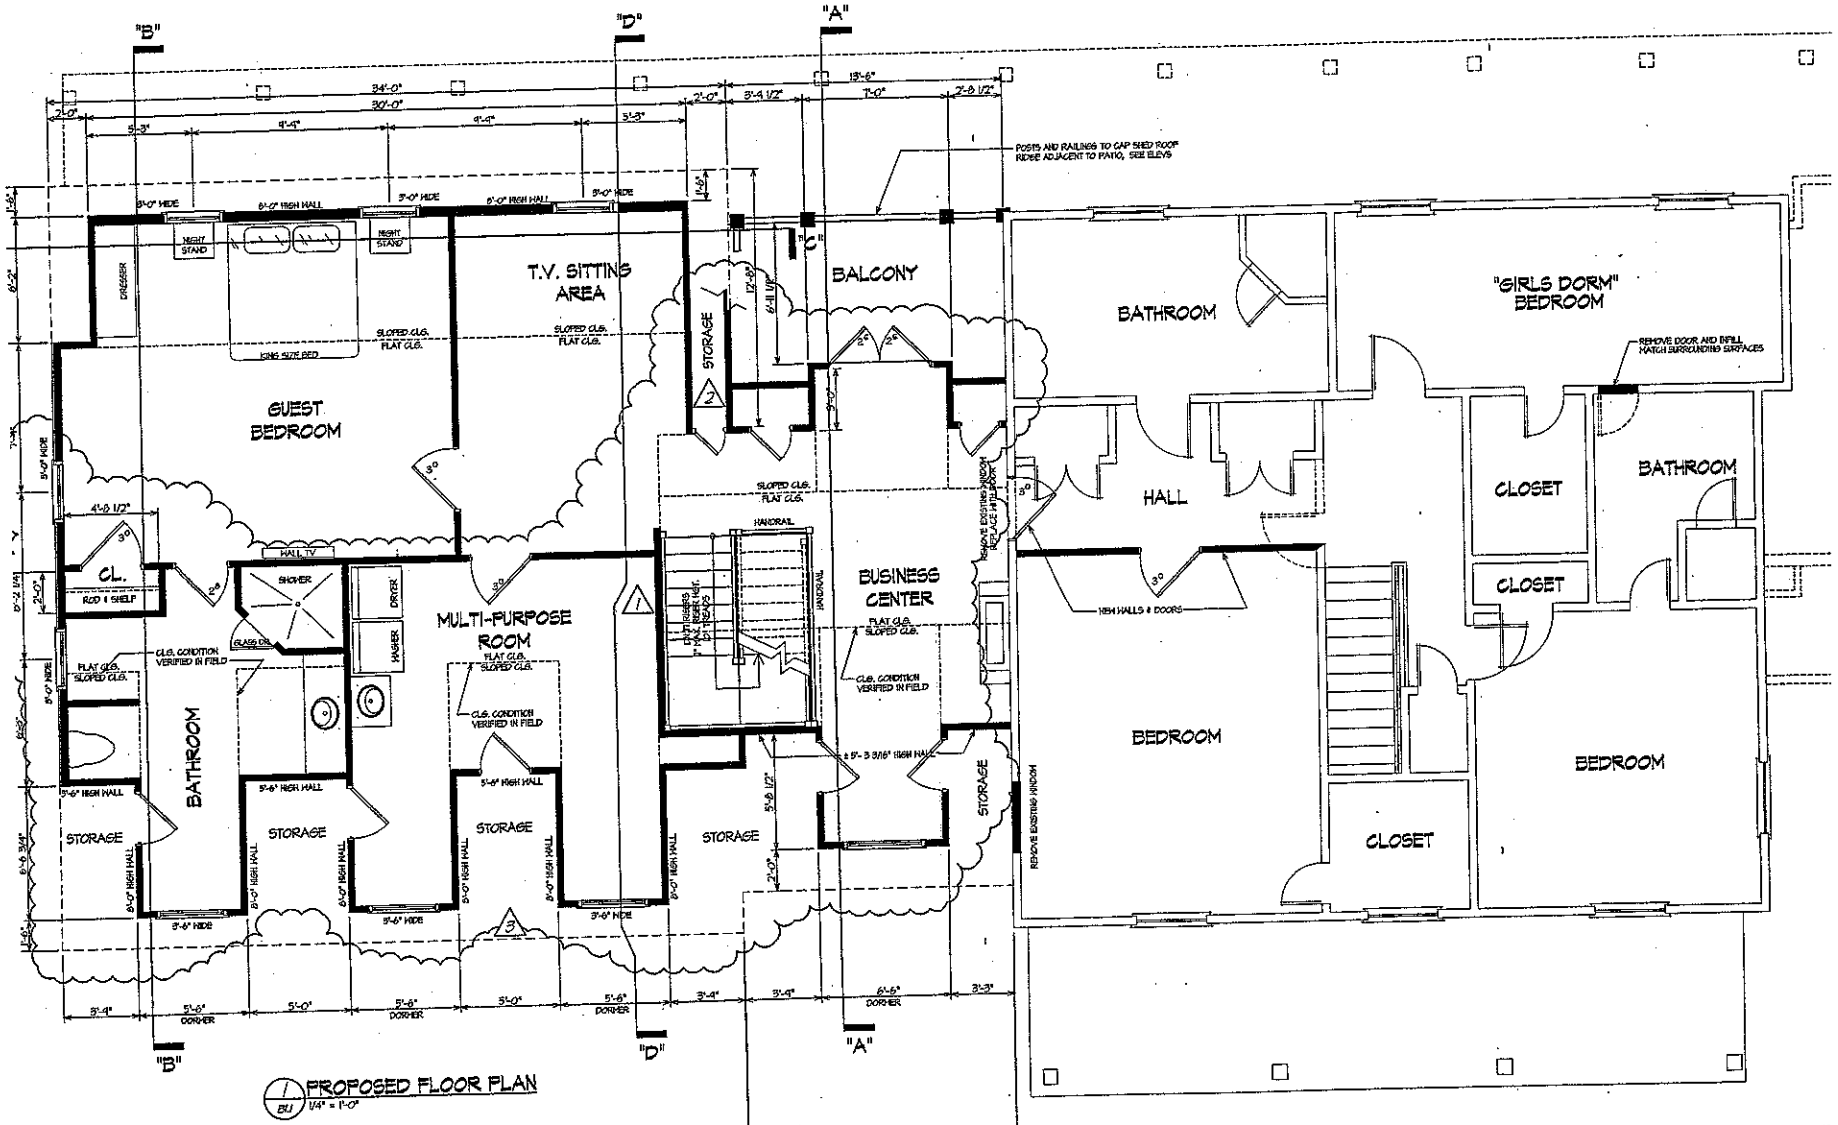

1/BU PROPOSED FLOOR PLAN
1/4" = 1'-0"

DIGITAL "AS-BUILT" DRAWING FOR EXISTING STRUCTURE PROVIDED BY OUTSIDE RESOURCE. ALL DIMENSIONS SHOULD BE VERIFIED FOR ACCURACY BEFORE CONSTRUCTION BEGINS. ANY DISCREPANCIES SHOULD BE BROUGHT TO THE ATTENTION OF THE DESIGNER FOR REMEDIATION.

Acknowledgement Of Plans Submittal ONLY!

STEVE HEDRICK Date 9/30/09

Date 12/9/09

G.L. W
BUILDING
100 WILSON PARK ROAD : STATESV
PHONE 704.872.2411 FAX 704.872.2051
Commercial and Industrial Cont

RESIDENTIAL