IREDELL COUNTY HEALTH DEPARTMENT

Statesville Phone TR 3-7271 Mooresville Phone NO 3-1271

PERMIT TO INSTALL SEPTIC TANK

Permit No. _____ Permit Date Oct 22 19 68

Owner James Bendfield Address Bristol Rd city

Installed By C Hoke Sons Address R 7


Location of Property 1st on left off 64-70 W behind Carolina Inn.

Tank		Capacity		Length of Lines		Fixtures	
Block	( )	1000	( )	225'	( )	No. of Baths	( )
Precast	( )	1250	( )	250'	( )	Dishwasher	( )
		1500	( )	Other _____		Garbage Grdr.	( )
		Other _____				Other _____	

NOTIFY HEALTH DEPARTMENT AT LEAST EIGHT HOURS BEFORE TANK IS TO BE INSPECTED.

Final Inspection _____ 19___ Approved ( ) Disapproved ( )

Remarks Well 150' - owner states no Dishwasher or G.G.

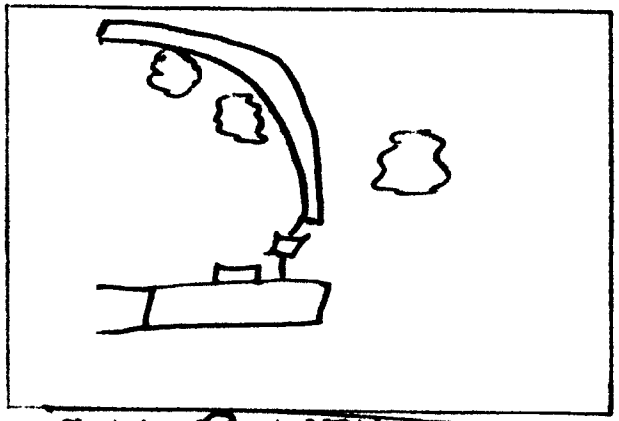

Sketch of Installation

Checked

R W Pettus

AH Sanitarian