IREDELL COUNTY HEALTH DEPARTMENT

Statesville Phone TR 3-7271 Mooresville Phone NO 3-1271

PERMIT TO INSTALL SEPTIC TANK

Permit No. _____ Permit Date 10-22 19 68

Owner James Benfield Address Statesville, NC

Installed By Clyde Hoke Address Statesville, NC


Location of Property Hwy 70 W, Rt Carolina Inn 1st house on left.

Tank		Capacity		Length of Lines		Fixtures	
Block	( )	1000	(✓)	225'	(✓)	No. of Baths	( )
Precast	( )	1250	( )	250'	( )	Dishwasher	( )
		1500	( )	Other _____		Garbage Grdr.	( )
		Other _____				Other _____	

NOTIFY HEALTH DEPARTMENT AT LEAST EIGHT HOURS BEFORE TANK IS TO BE INSPECTED.

Final Inspection 10-22 19 68 Approved (✓) Disapproved ( )

Remarks _____

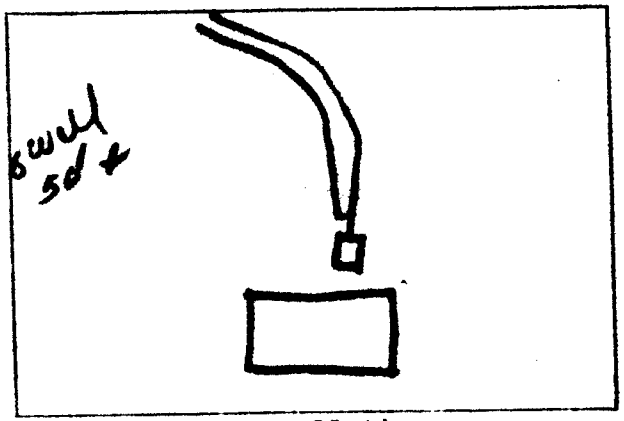

Sketch of Installation

Andrew J. Hutchinson Sr

Sanitarian