IREDELL COUNTY HEALTH DEPARTMENT

Statesville Phone TR 3-7271 Mooresville Phone NO 3-1271

PERMIT TO INSTALL SEPTIC TANK

Permit NO. _____ Permit Date AUG 6 1958

Owner PAUL BARNES Address STATESVILLE

Installed By OSTWALT Address _____


Location of Property OFF #70 RIGHT AT CAROLINA INN LEFT ½ MILE NEW DEVELOPMENT - ~~NEXT~~ THE LAST HOUSE ON LEFT

Tank		Capacity		Length of Lines		Fixtures	
Block	(✓)	800	( )	150'	(✓)	No. of Baths	(1)
Precast	( )	900	(✓)	175'	( )	Dishwasher	( )
		1000	( )	200'	( )	Garbage Grdr.	( )
		1100	( )	225'	( )	Auto-Washer	( )
		1200	( )	250'	( )	Other	_____
		Other	_____	Other	_____		

NOTIFY HEALTH DEPARTMENT AT LEAST EIGHT HOURS BEFORE TANK IS TO BE INSPECTED.

Final Inspection AUG 6 1958 Approved (✓) Disapproved ( )

Remarks HOWELL OWN PROPERTY

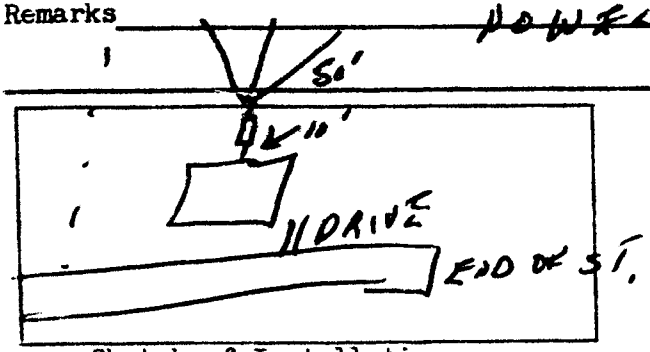

Sketch of Installation

Rufus A. Thomas

Sanitarian