IREDELL COUNTY HEALTH DEPARTMENT

STATESVILLE 704-878-5305 MOORESVILLE 704-664-5281

IMPROVEMENT PERMIT / AUTHORIZATION TO CONSTRUCT / OPERATION PERMIT / EXISTING SYSTEM INSPECTION

PERMIT# REPAIR PIN# 4724-54-1071 DATE 8-10-04

OWNER OR CONTRACTOR GENEVA CHAPMAN PHONE: Business Home 704-872-7756

ADDRESS 818 REYNOLDS ROAD, STATESVILLE NC 28677

LOCATION US 70 WEST, TR REYNOLDS ROAD 6TH HOUSE ON LEFT AT # 818

SUBDIVISION BLOCK / SECTION LOT LOT AREA 98' x 260' SITE CLASS. PS DESIGN FLOW 240 L.T.A.R. EXISTING 0.36 GPD/FT²

Septic Tank: EXISTING Gallons; STB Date

Pump Tank: Gallons; PT Date

Pump Make: Model Serial No.

Nitrification Field: No Fields 1 Square Feet 600' Linear Feet 200

No Lines TWO Trench Width 36" Max Trench Bottom Depth 36" Gravel Depth 12"

☐ New System ☑ Repair System Type: I, II, III, IV, V, VI

System Description: CONVENTIONAL GRAVITY

Repair System Description: CONVENTIONAL, GRAVITY

Maintenance Agreement Required: ☐ Yes ☑ No

☑ House/Mod. Home No. Bedrooms 2

☐ Mobile Home No. Bathrooms 2

☐ Business No. Employees

☐ Other


☐ Slab ☑ Crawl Space ☐ Basement w/plumbing ☐ Basement wo/plumbing

Water Supply: ☑ Individual ☐ Public ☐ Community WELL


Comments:/Conditions: (1) INSTALL NEW SANITARY TEE IN SEPTIC TANK IF NECESSARY (2) THIS PERMIT SERVES AS "NOTICE OF VIOLATION" TO BE REPAIRED WITHIN 30 DAYS (by 9-10-04)

Comments:/Conditions: SEPTIC TANK MAY NEED TO BE REPLACED SOON

INITIAL SITE SKETCH

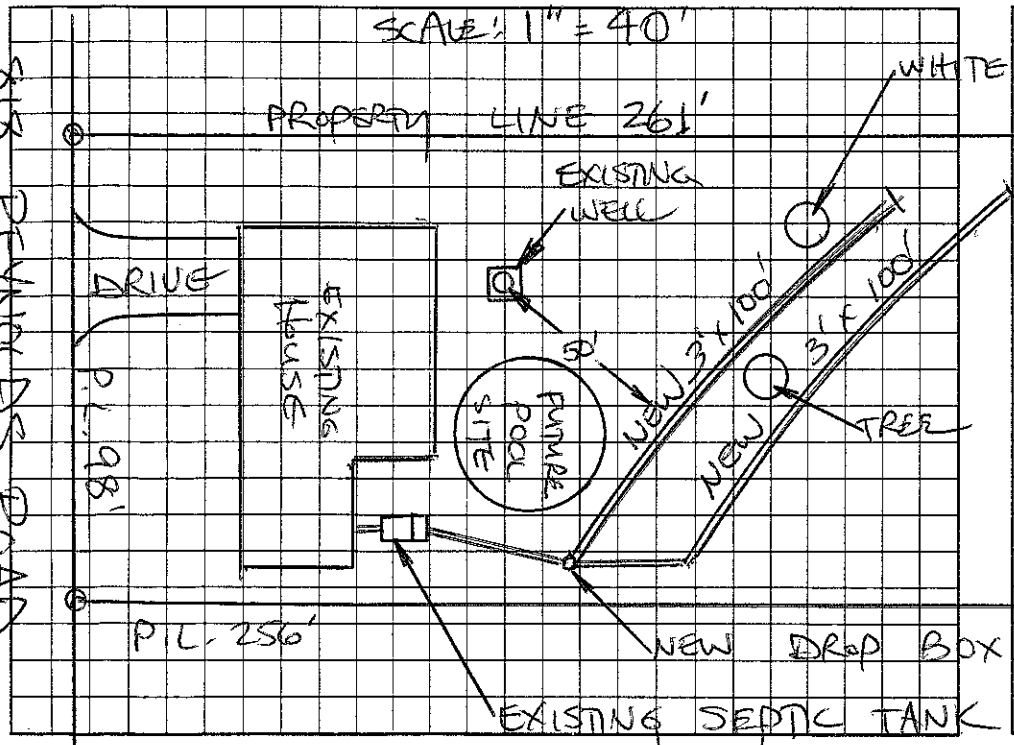

AS BUILT SKETCH

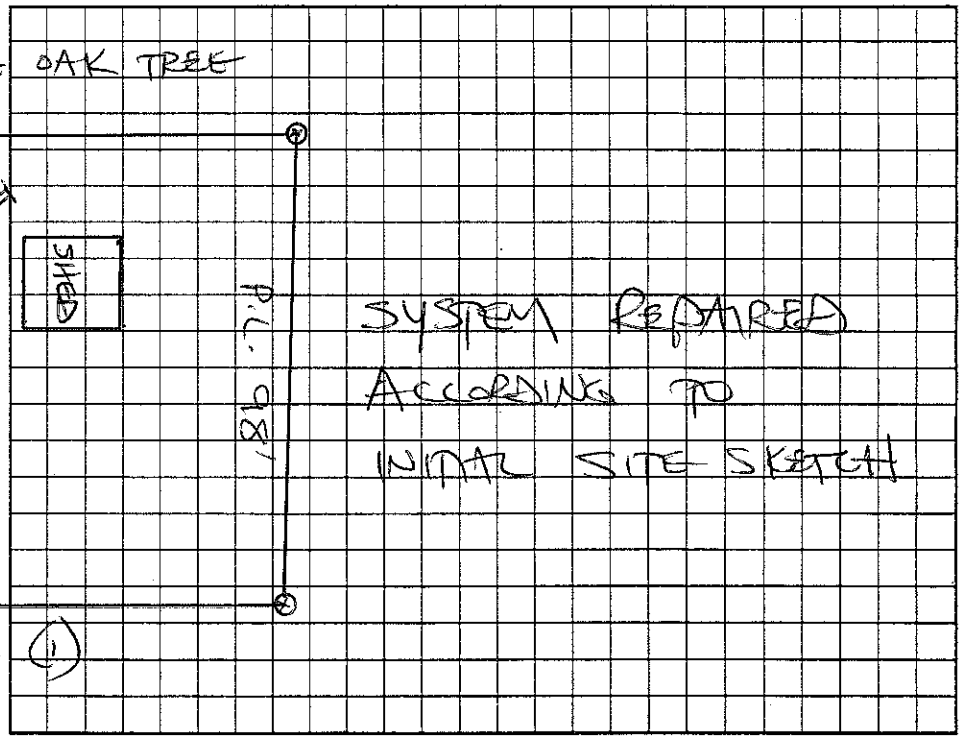

Permit can be suspended or revoked if any false information is supplied toward securing the permit/any unauthorized changes are made to the site/any unauthorized changes are made in the installation of the system. Improvement Permit with plat valid without expiration. Improvement Permit with site plan valid for sixty months. Authorization to Construct is valid for a period equal to that of Improvement Permit – not to exceed sixty months.

Signed: Terry L Chapman date 8-10-4 Installed by: JAMES HUNTER

Improvement Permit by: STEVE HEDRICK date 8-10-04 Operation Permit by: STEVE HEDRICK date 8-23-04

Authorization to Construct by: STEVE HEDRICK date 8-10-04 Existing System Inspection by: date

HEALTH DEPT. COPY: WHITE OWNER COPY (FINAL): YELLOW OWNER COPY (INITIAL): PINK