IREDELL COUNTY HEALTH DEPARTMENT

Statesville Phone TR 3-7271 — Mooresville Phone NO 3-1271

PERMIT TO INSTALL SEPTIC TANK

Permit NO. _____ Permit Date AUG 6 1958

Owner PAUL BARNES Address STATESVILLE N.C.

Installed By OSTWALT Address _____


Location of Property OFF #21 RIGHT AT CAROLINA INN ON LEFT LEFT ½ MILE - NEW DEVELOPMENT - NEXT TO LAST HOUSE

Tank		Capacity		Length of Lines		Fixtures	
Block	(✓)	800	( )	150'	(✓)	No. of Baths	(1)
Precast	( )	900	(✓)	175'	( )	Dishwasher	( )
		1000	( )	200'	( )	Garbage Grdr.	( )
		1100	( )	225'	( )	Auto-Washer	( )
		1200	( )	250'	( )	Other _____	
		Other _____		Other _____			

NOTIFY HEALTH DEPARTMENT AT LEAST EIGHT HOURS BEFORE TANK IS TO BE INSPECTED.

Final Inspection AUG 6 1958 Approved (✓) Disapproved ( )

Remarks _____

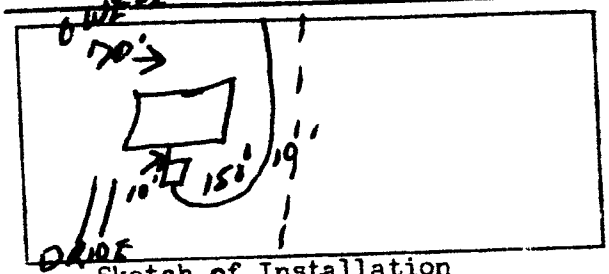

Sketch of Installation

Rufus A. Thomas

Sanitarian